

**Norwalk**  
**Building 43**  
Norwalk, California

**Skidmore, Owings & Merrill**  
Architects/Engineers  
One Maritime Plaza  
San Francisco, California


**Jaros, Baum & Bolles**  
Consulting Engineers  
345 Park Avenue  
New York, New York

Approved for the Owner by	
Approved for the Architect by	
Drawn by	Job Number
Checked by	Date

Q.	Revisions Indicated than A:	Date
1	ISSUED FOR BID	12-15-81
2	ADDENDUM # 20	2-4-82
3	ADDENDUM # 104	2-25-83
4	ADDENDUM # 126	6-1-83
5	AS BUILT	1-5-84

[illegible]



Key Plan

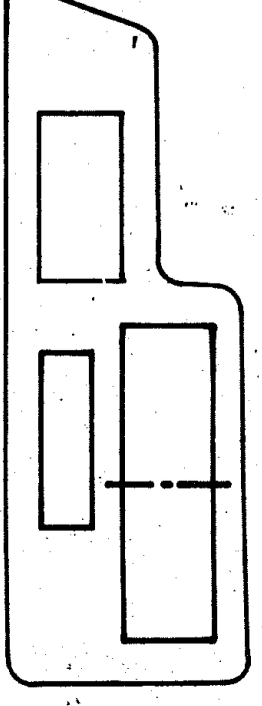

## GROUND FLOOR PLAN WEST - LIGHTING

SCALE: 1/8"=1'-0"

३९

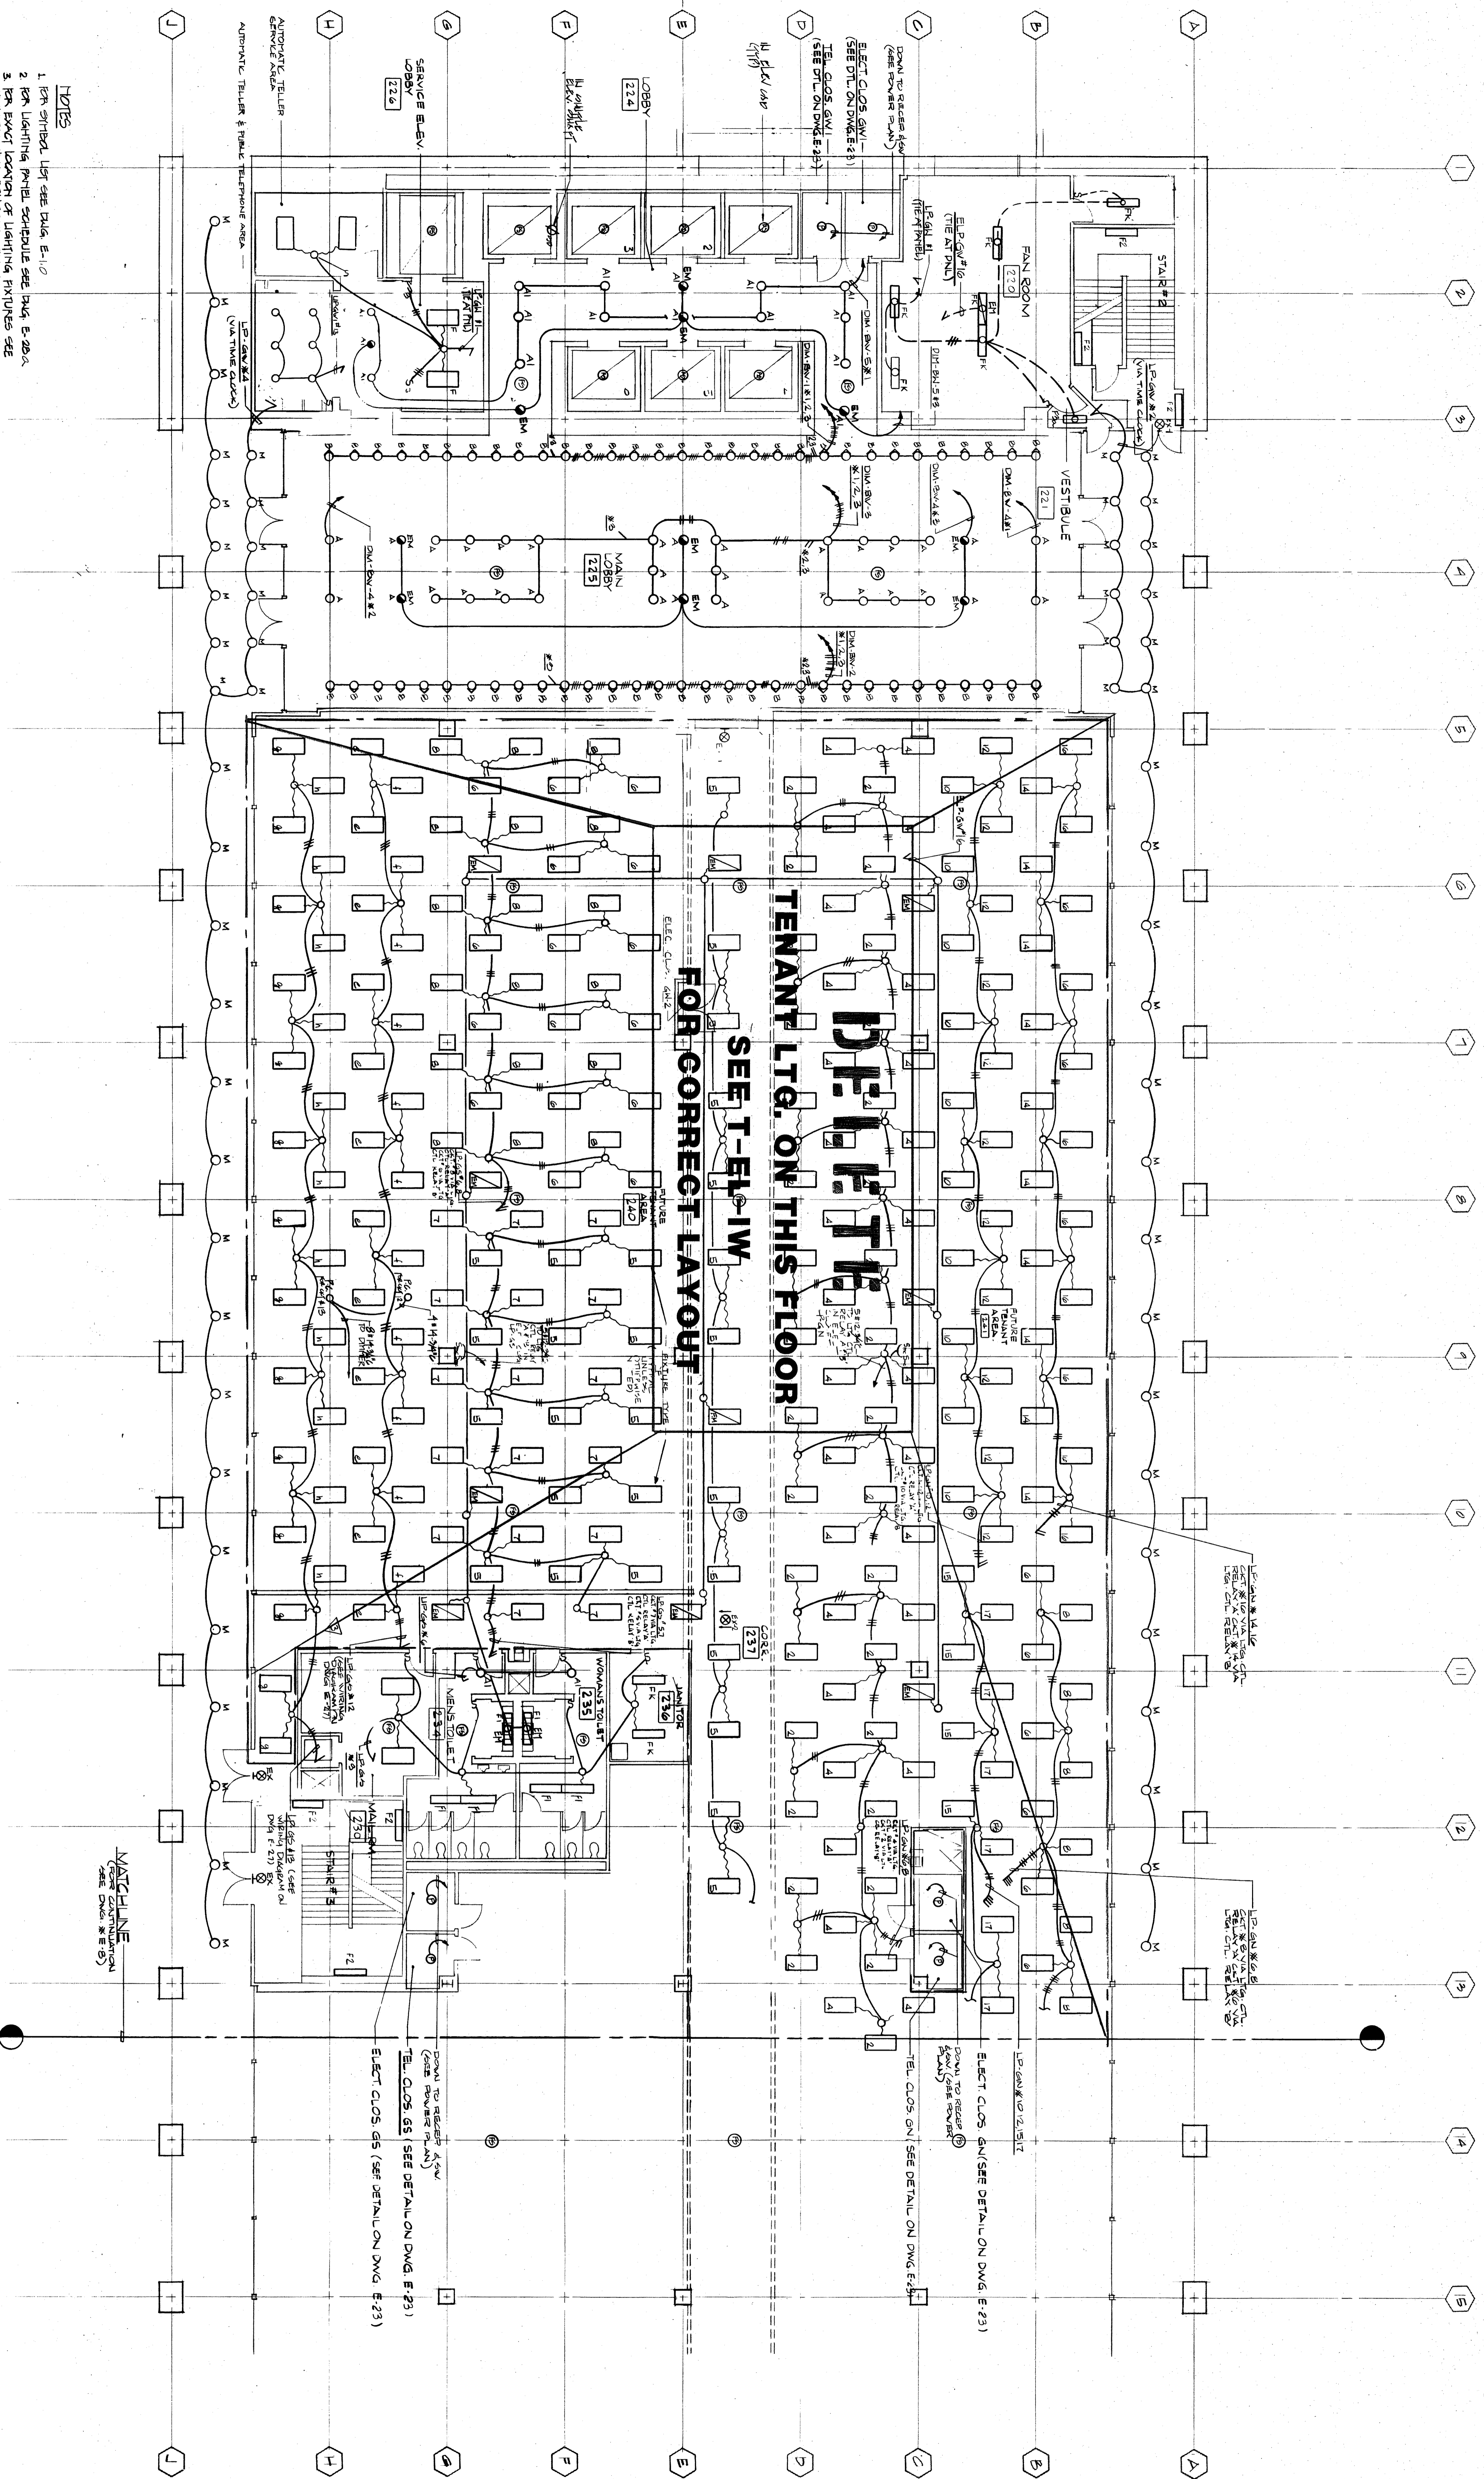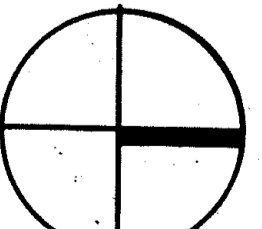

**USE FOR BASE BLDG. LTG. ONLY.  
SEE T-EL-IW FOR TENANT LTG.**

NOTES

1. FOR SYMBOL LIST SEE DWG. E-110

2. FOR LIGHTING PANEL SCHEDULE SEE DWG. E-220A

3. FOR EXACT LOCATION OF LIGHTING FIXTURES SEE ARCHITECTURAL REFLECTED CEILING PLAN