


Norwalk
Building 43
Norwalk, California

Skidmore, Owings & Merrill
Architects/Engineers
One Maritime Plaza
San Francisco, California

James, Baum & Boles
Consulting Engineers
345 Park Avenue
New York, New York

Approved by the Owner by	
Approved for the Engineer by	
Checked by	
Revisions	
1. AS-BUILT	12-1-68
2. CORRECTION	12-1-68
3. ADDITION	12-1-68
4. MODIFICATION	12-1-68
5. ADDITION	12-1-68

RECEIVED
NOV 04 1968
SPACE PLANNING & ALLOCATION
NO. 04 1968

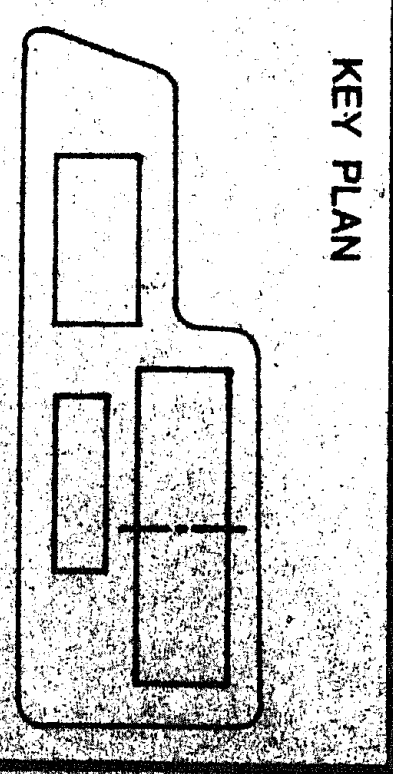

GROUND FLOOR PLAN
WEST - POWER

SCALE 1/8" = 1'-0"

E-7

