

Norwalk
Building 43

Norwalk, California

Schnee Owing & Merrill
Consulting Engineers
One Maritime Plaza
San Francisco, California

James Baum & Spolans
Consulting Engineers
345 Park Avenue
New York, New York

Approved by the Owner by
Approved by the Architect by

Drawn by
Checked by
Date


Revisions
Numbered Indicated Item & Date

NO. 1
LOCALIZED TYPED BY
APPROVED BY
DATE
2.4.83

AS BUILT 1-15-84

BECHTEL
JOB NO. 048-3000
SAN FRANCISCO

KEY PLAN
N

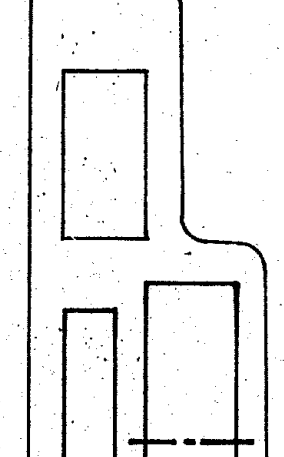

TELEPHONE, STAIR
& ELECTRICAL RISER
DIAGRAM

E.20

3-15-84

