




Norwalk, California

Jaros, Baum & Bolles
Consulting Engineers
345 Park Avenue
New York, New York

| | | |
|---|--|----------|
| △ | ADENDUM # 20 | 12-15 |
| △ | ADENDUM # 3 ISSUED BY BLDG DEPT RE: 15-000 FOR BUILDING PERMIT | 12-15-80 |
| △ | ADENDUM # 45 | 6-2-82 |
| △ | ADENDUM # 40 | 6-5-82 |
| △ | ADENDUM # 39 | 11-0-82 |
| △ | ADENDUM # 38 | 1-10-83 |
| △ | ADENDUM # 37 | 1-19-83 |
| △ | ADENDUM # 36 | 2-8-83 |
| △ | AS BUILT | |

TECHNICAL

2-15-84

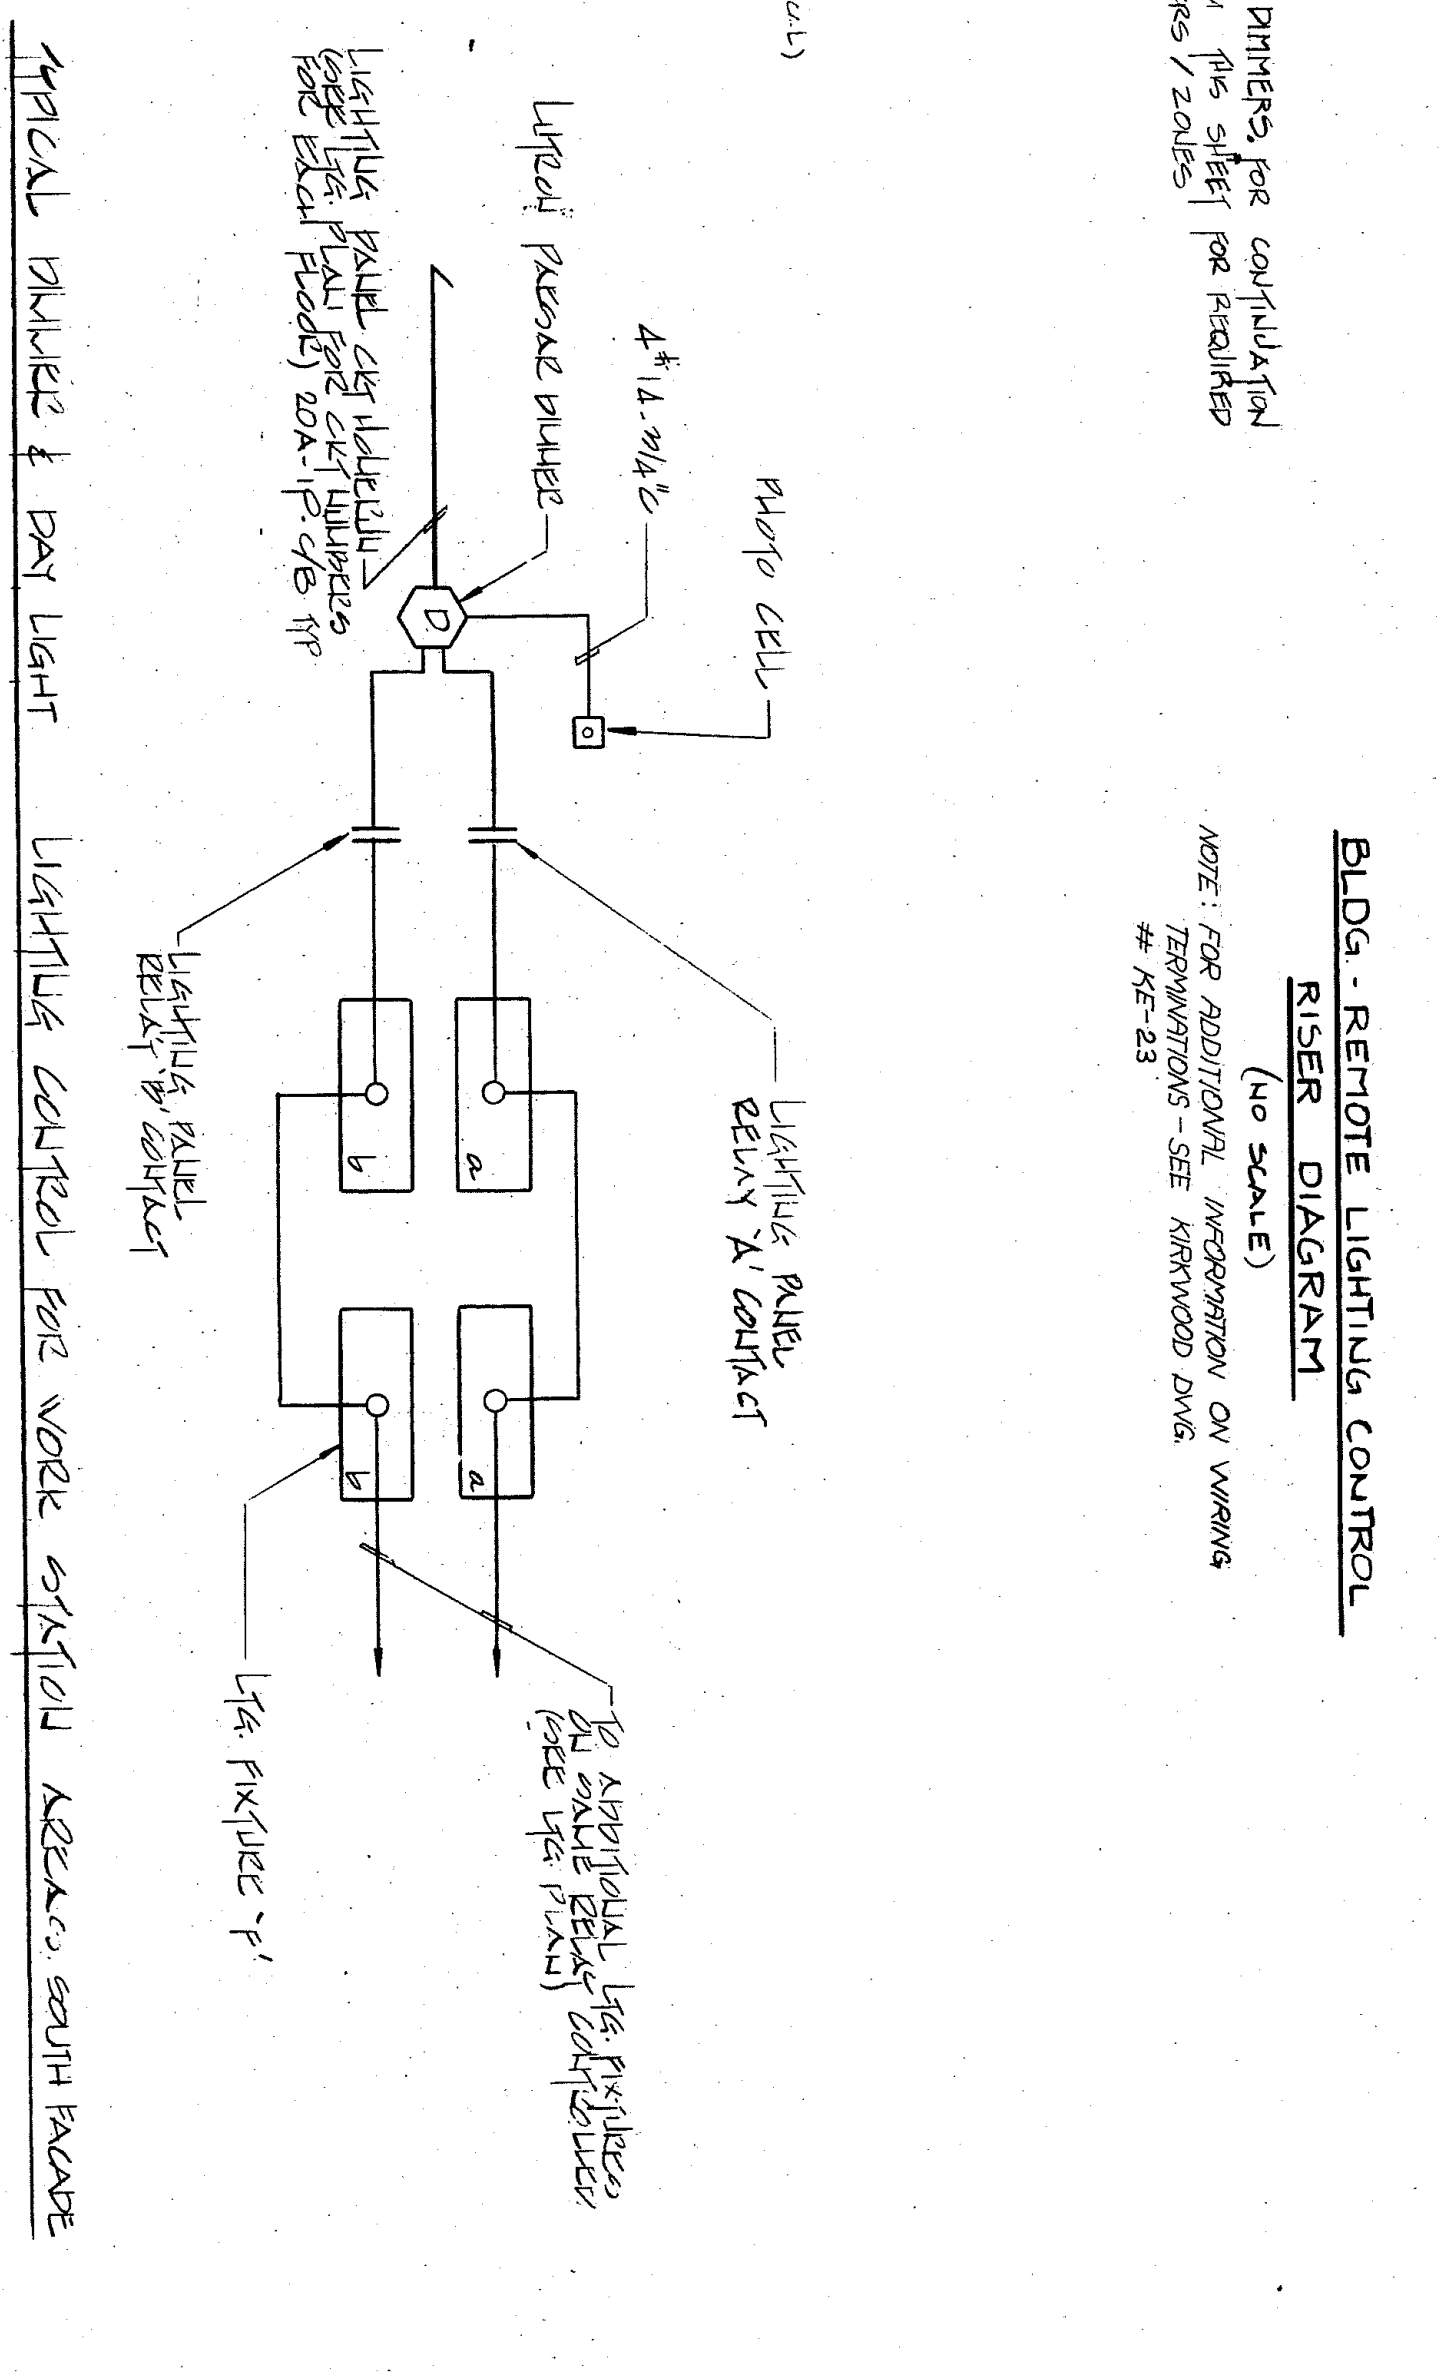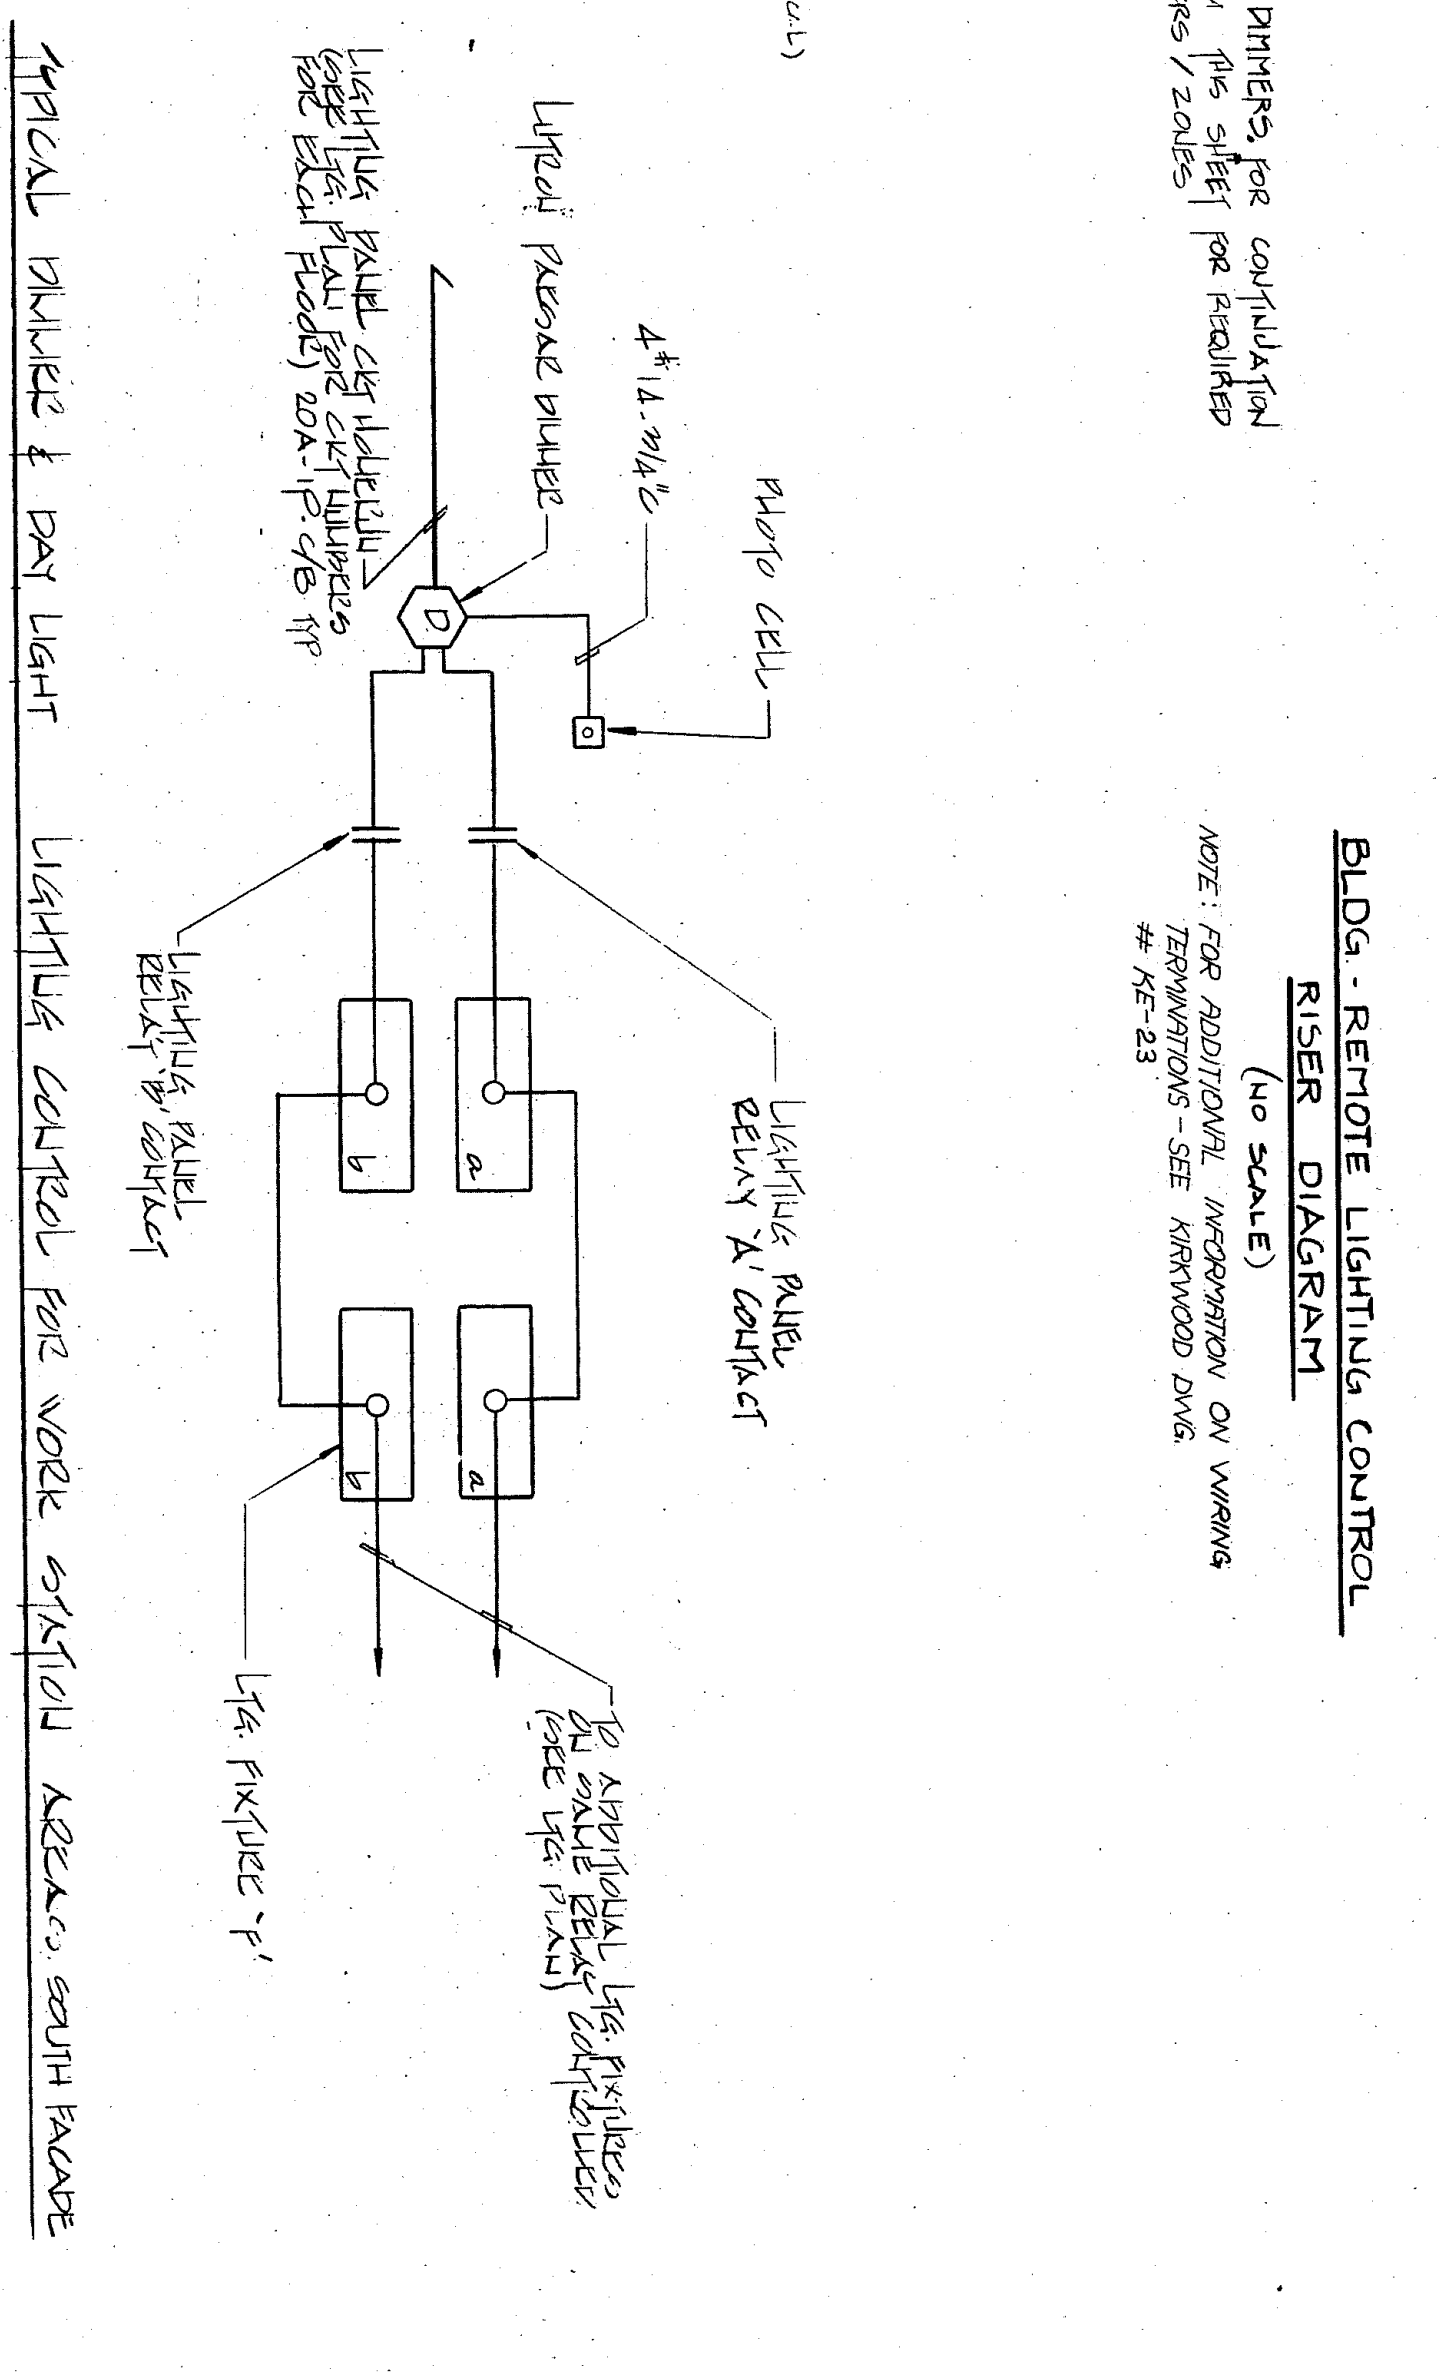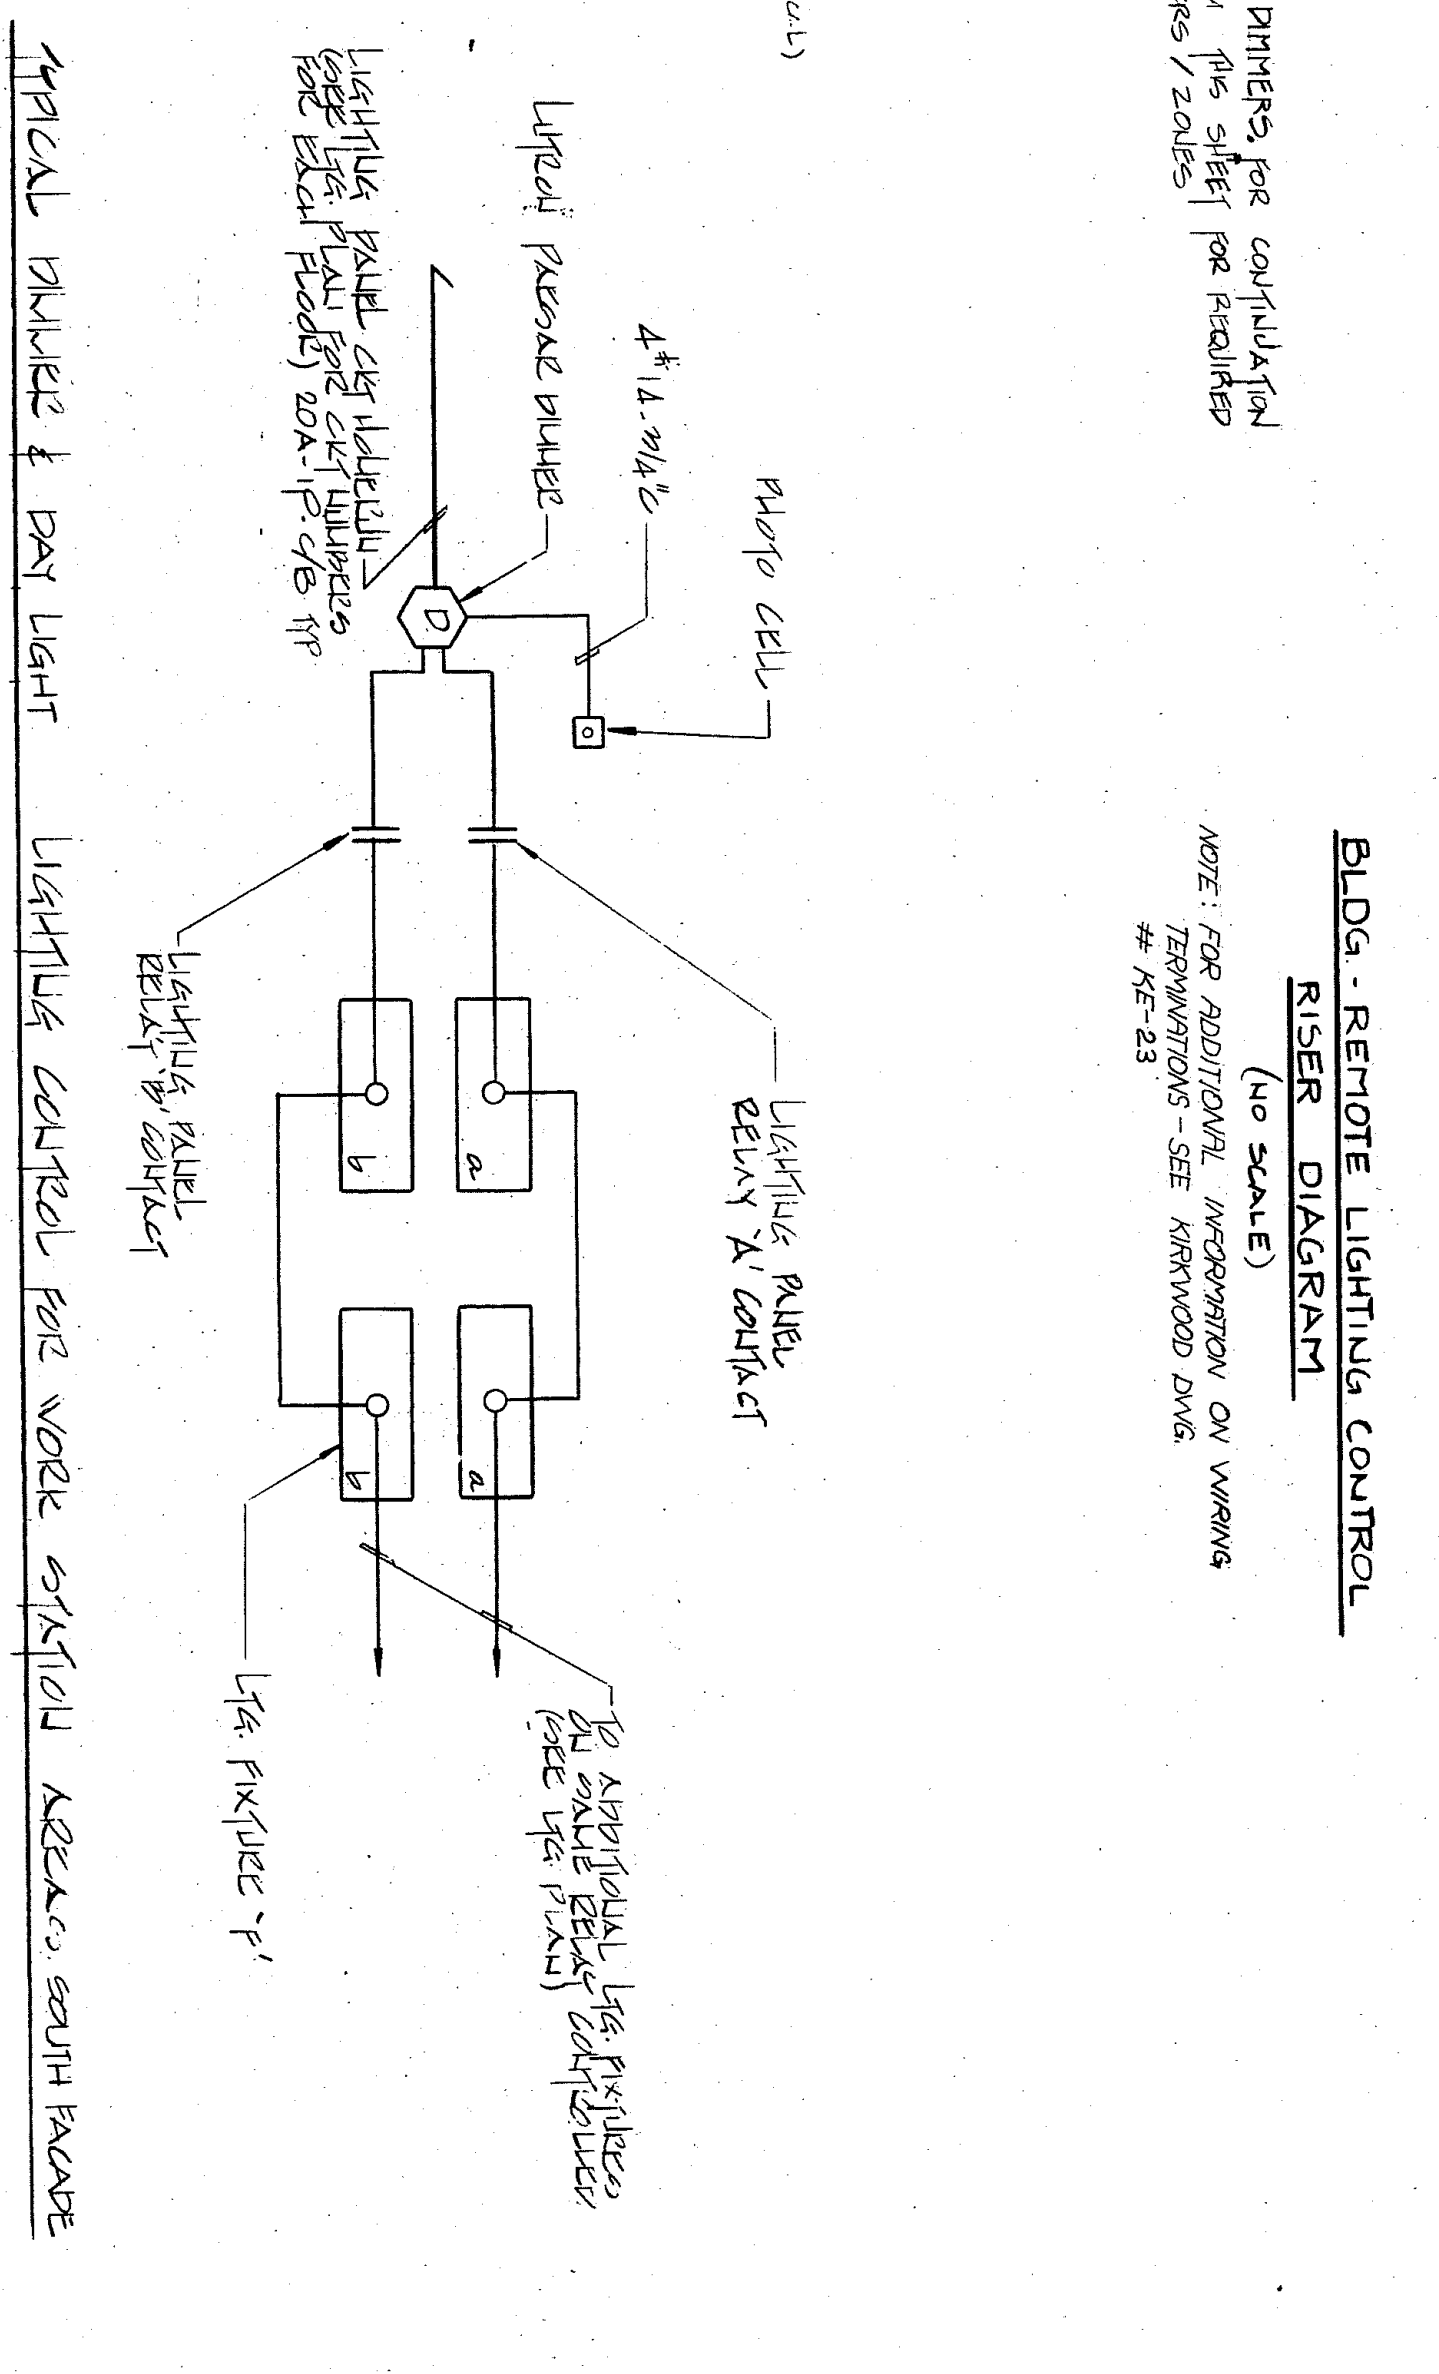


| MANUFACTURER | | FIGURE 14-57 |
|--------------|--|---|
| TYPE | | FINISH |
| A | LIGHTGRIP # 7055 | SPECIAL FINISH (DOOR TO AIR SELECTED BY ARCHT.) |
| B1 | LIGHTGRIP # 7054 | |
| B | LIGHTGRIP # 7042 - NO | |
| B1 | LIGHTGRIP # 7042 - NO | |
| F | KEENE # 2 SW-40-27V W/WHOLEHOLE # 8224 LENS, 7" FL. RIMS (ELECT. SUB. CAB.) | ↓ |
| F* | COLSON #4535-45-244 W/WHOLEHOLE LENS (NO FL. CAB.) | CONCRETE BARS W/INT. EMERGE. HANGS FROM 6" HANG SIZES |
| F1 | LIGHTGRIP # FL.BT 7042-48 AS | WHITE BAVED ENAMEL |
| F2 | LIGHTGRIP # 8284 | WHITE BAVED ENAMEL |
| F3 | KEENE # CIBONS /WHF | WHITE BAVED ENAMEL |
| F4 | KEENE # CIBONS - T | WHITE BAVED ENAMEL |
| F5 | KEENE # 571 240-27V | WHITE BAVED ENAMEL |
| F6 | KEENE # 571 240-27V | WHITE BAVED ENAMEL |
NOTE: ALL FLUORESCENT FIXTURES TO HAVE ENERGY EFFICIENT BALLAST

"A" - RELAY CONTROLS 2 OUTSIDE LAMPS IN MASTER AND SLAVE (2 BALLAST)

"B" - RELAY CONTROLS 1 CENTER LAMP IN MASTER AND SLAVE (1 BALLAST)

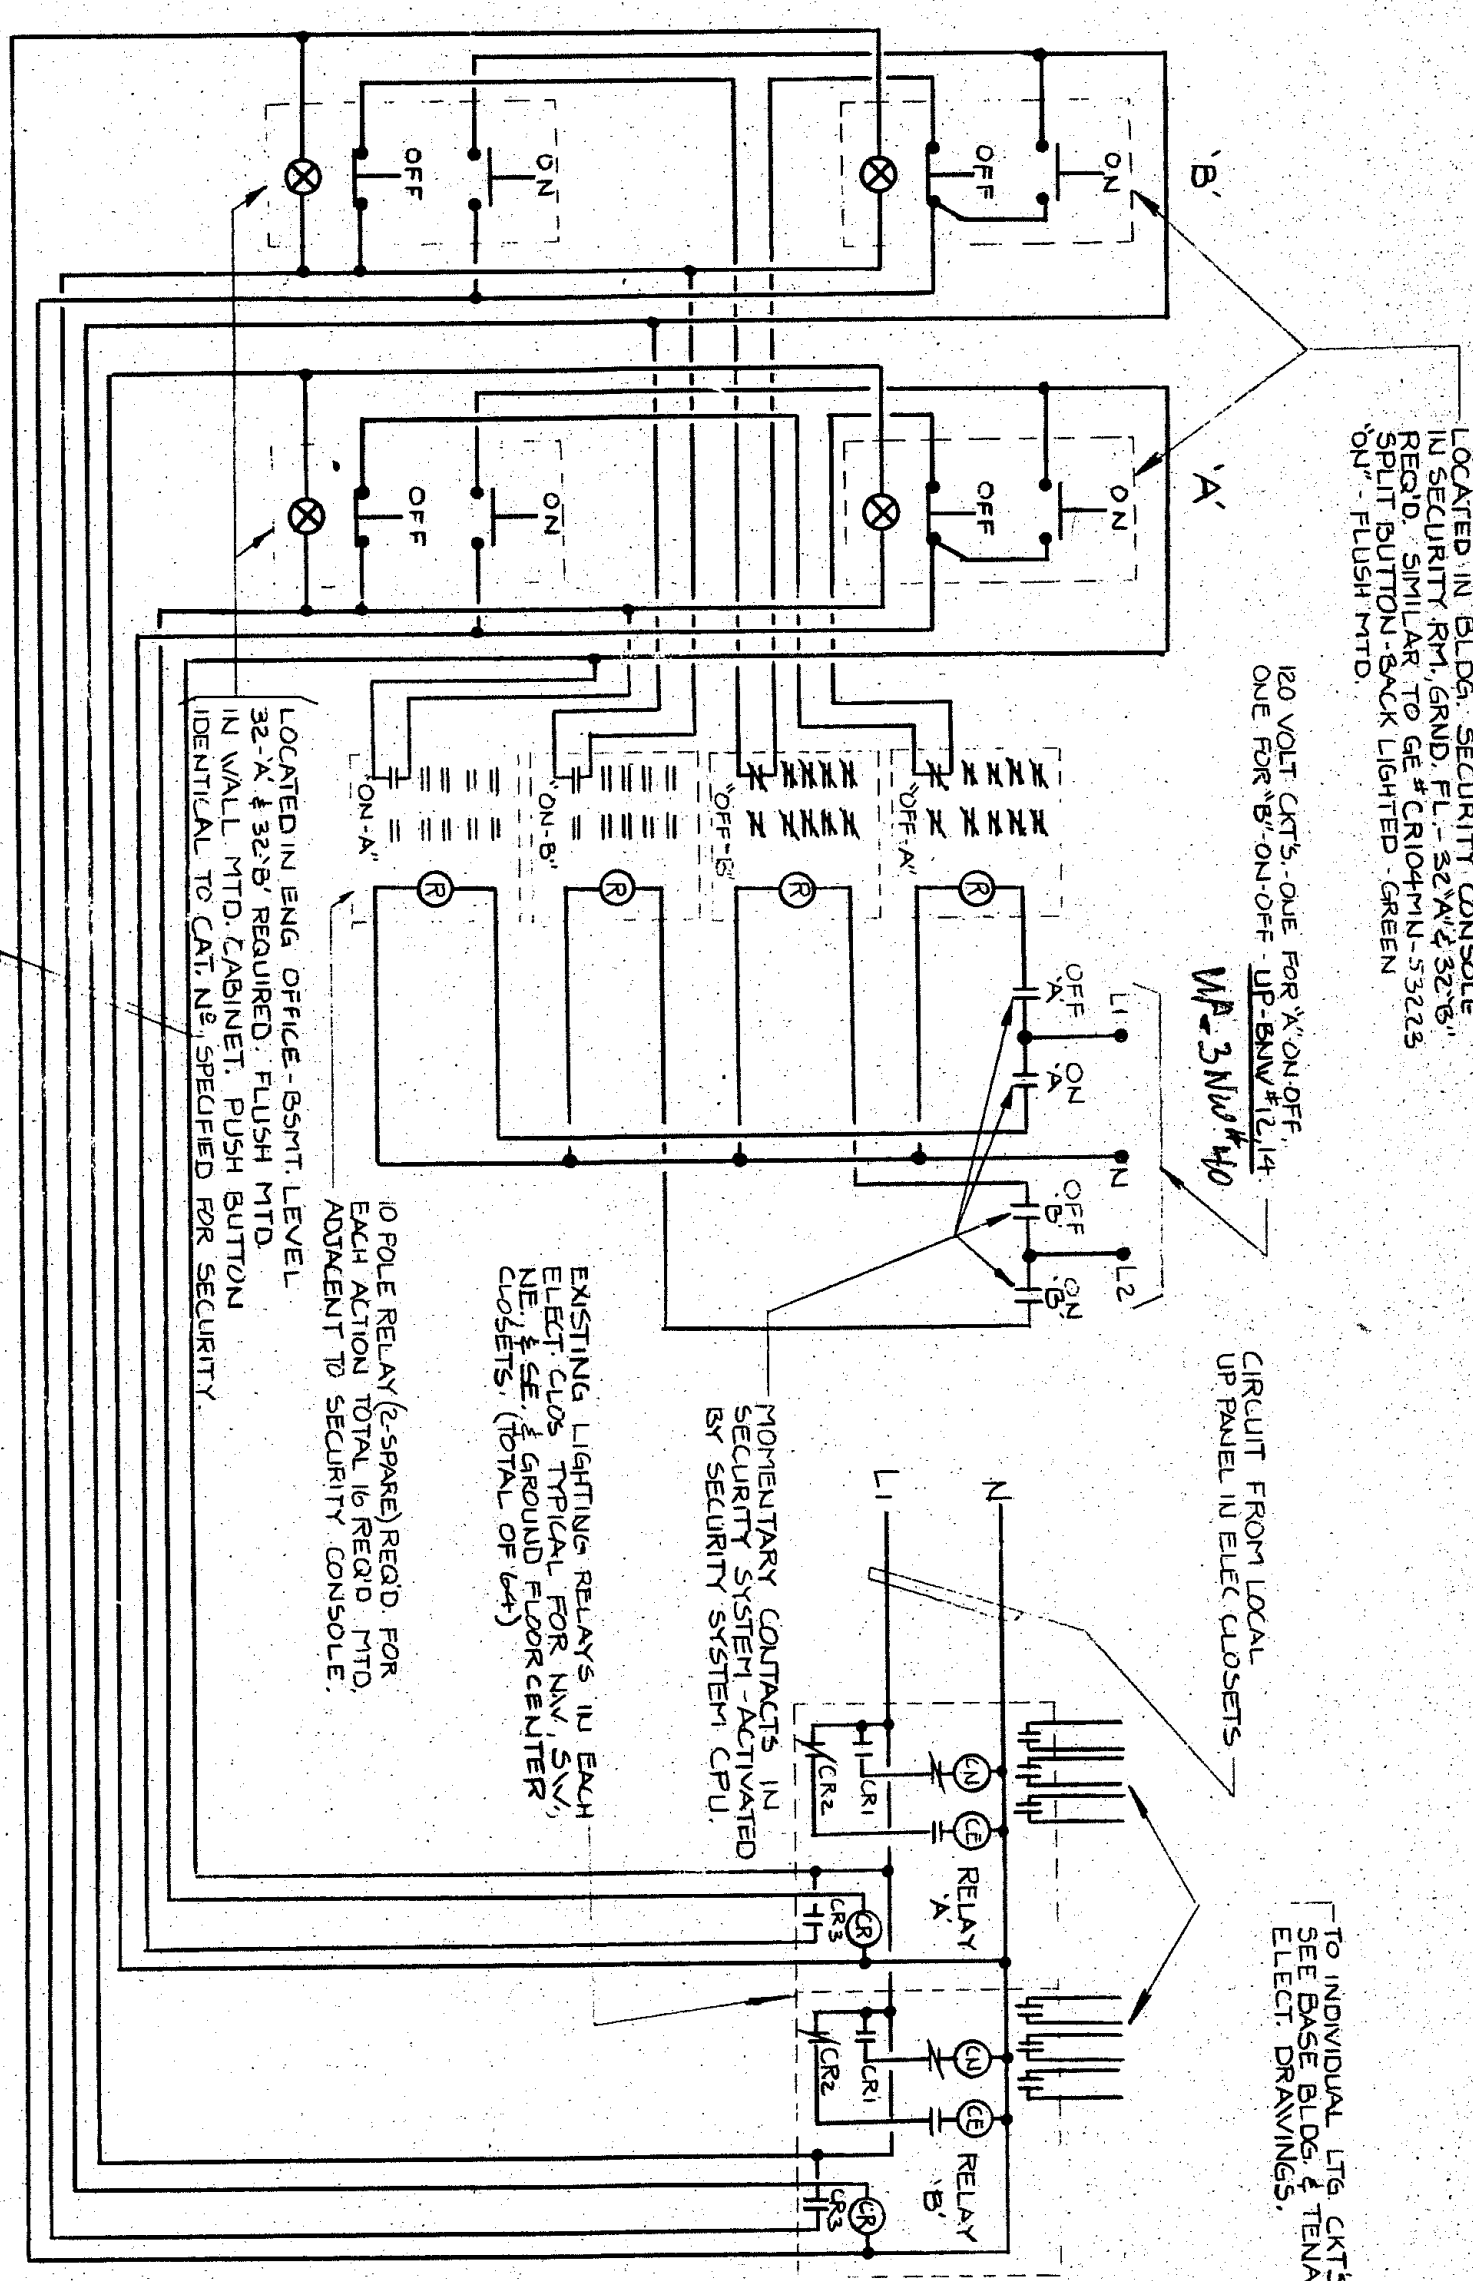[illegible]

NOTE THE CLOCK PROGRAMMER WILL BE LOCATED IN KITCHEN PAK. SEE SPECIFICATION FOR DETAIL.

EACH COMPLETE DINNER BAK. ASSEMBLY SHALL BE U.L. RATED.

1. ☒ SEE TYPICAL DINNER PAK AND EMERGENCY TROUBLESHOOT. DETAIL THIS SHEET

2. ☒ SEE DINNER RISER DRAWING, IN SHEET E-28