

Norwalk
Building 43
Norwalk, California


Sidmore, Owings & Merrill
Architects/Engineers
One Maritime Plaza
San Francisco, California

Jura, Baum & Bolles
Consulting Engineers
345 Park Avenue
New York, New York

Approved by the Owner by _____		
Approved by the Architect by _____		
Drawn by _____	Job Number _____	
Checked by _____	Date _____	
Revisions		
No.	Revisions Indicated Here As	Date
1	ISSUED FOR BID	12-15-81
2	ADDITIONAL WORK # 20	6-4-82
3	ADDITIONAL WORK # 104	2-6-83
4	ADDITIONAL WORK # 126	6-1-85
5	ADDITIONAL WORK # 154	1-5-84

NO. 1	AS BUILT UPDATE	TO: H&J
NO. 2	REVISION	DATE: 12-15-81
NO. 3	REVISION	DATE: 6-4-82
NO. 4	REVISION	DATE: 2-6-83
NO. 5	REVISION	DATE: 6-1-85

KEY PLAN

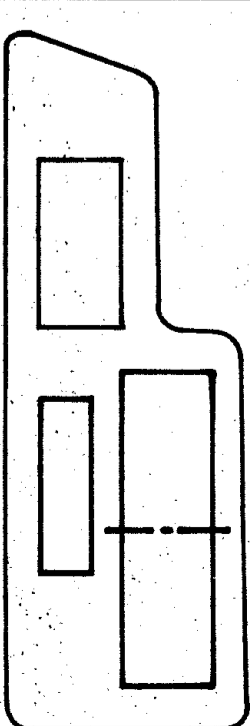

GROUND FLOOR PLAN
EAST - LIGHTING

SCALE: 1/8"=1'-0"

E-8

USE FOR BASE BLDG. LTG. ONLY
SEE T-EL-IE FOR TENANT LTG.

- NOTES**
1. FOR SYMBOL LAY SEE DIAG. E-30
 2. FOR LIGHTING PANEL SCHEDULE SEE DIAG. E-28A
 3. FOR EXACT LOCATION OF LIGHTING FIXTURES SEE ANNOTATIONAL REFLECTED CEILING PLAN

WATCH LINE
FOR CONTINUATION
SEE PAGE E-9

REFLECTED
TENANT LTG. ON THIS FLOOR
SEE T-EL-IE
FOR CORRECT LAYOUT

