

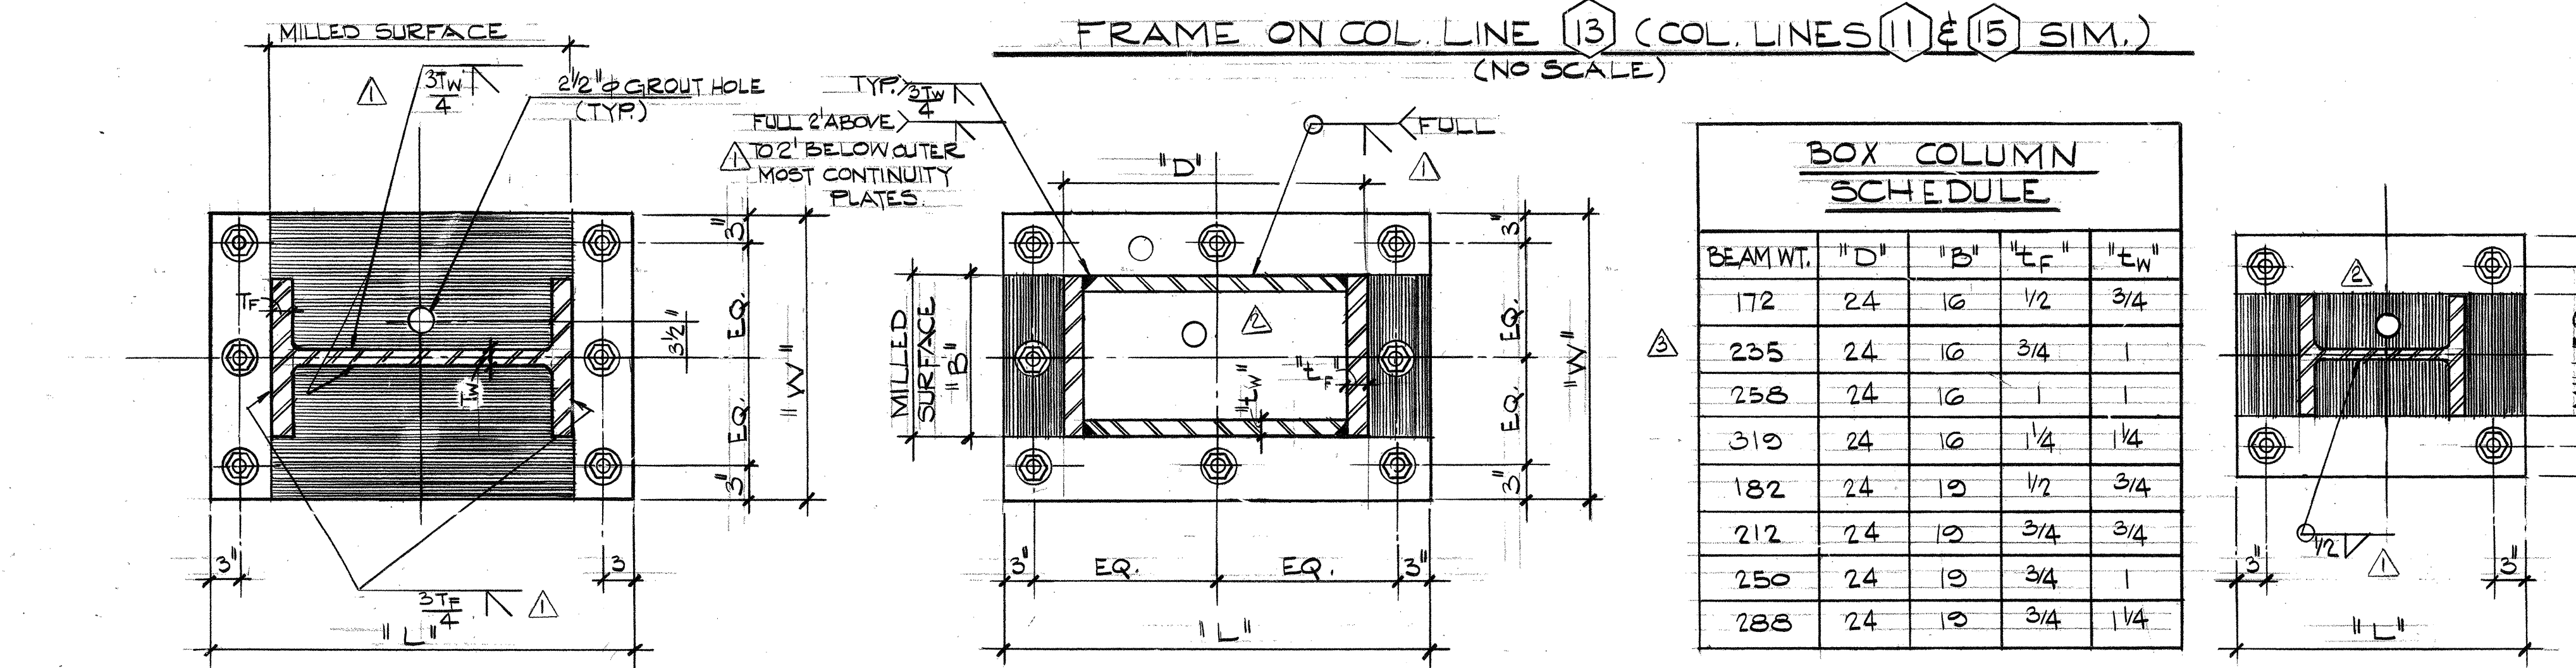
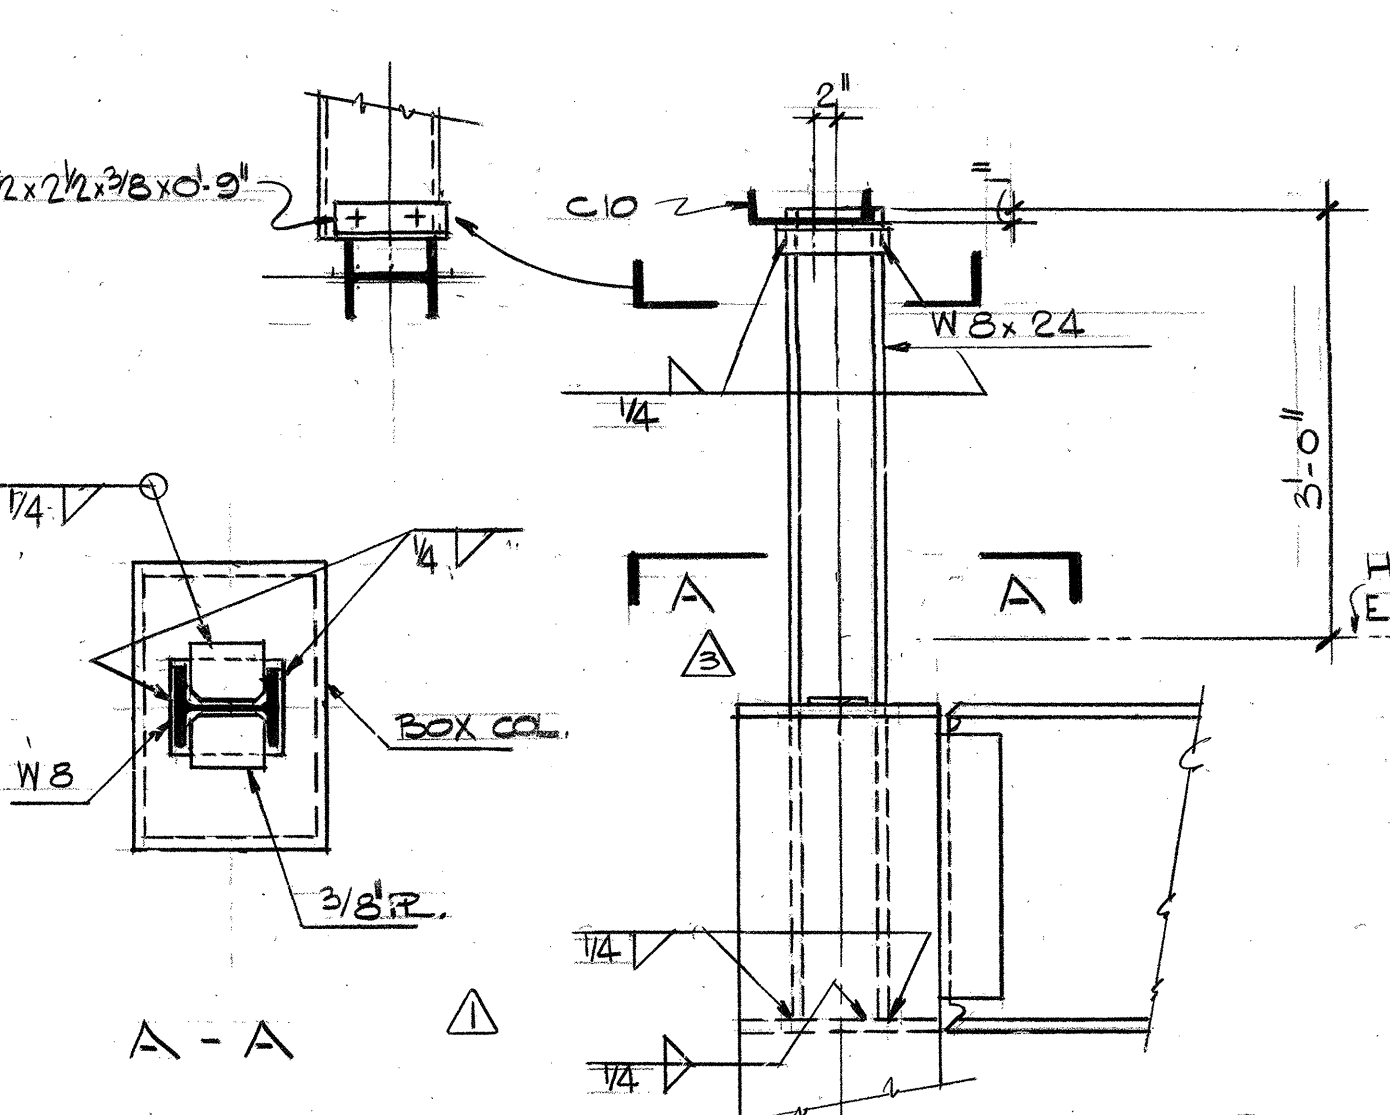
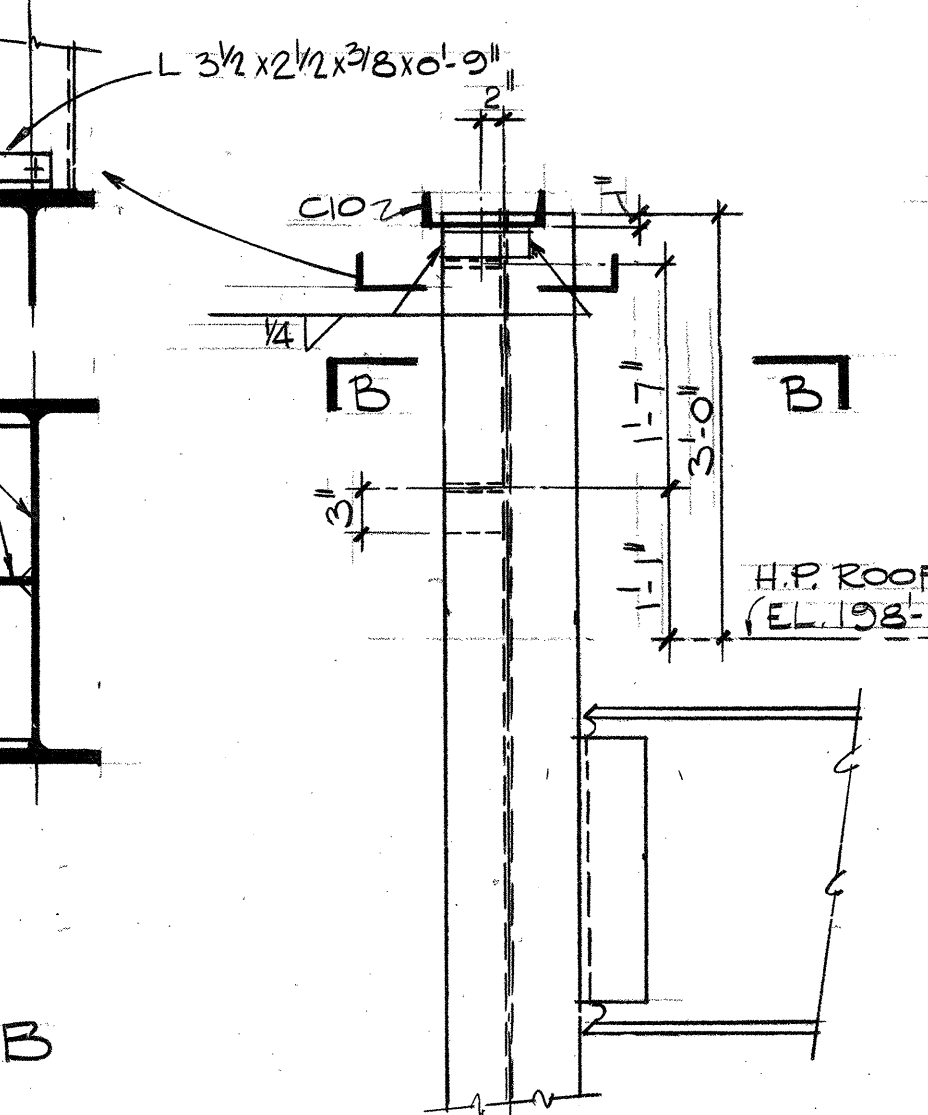
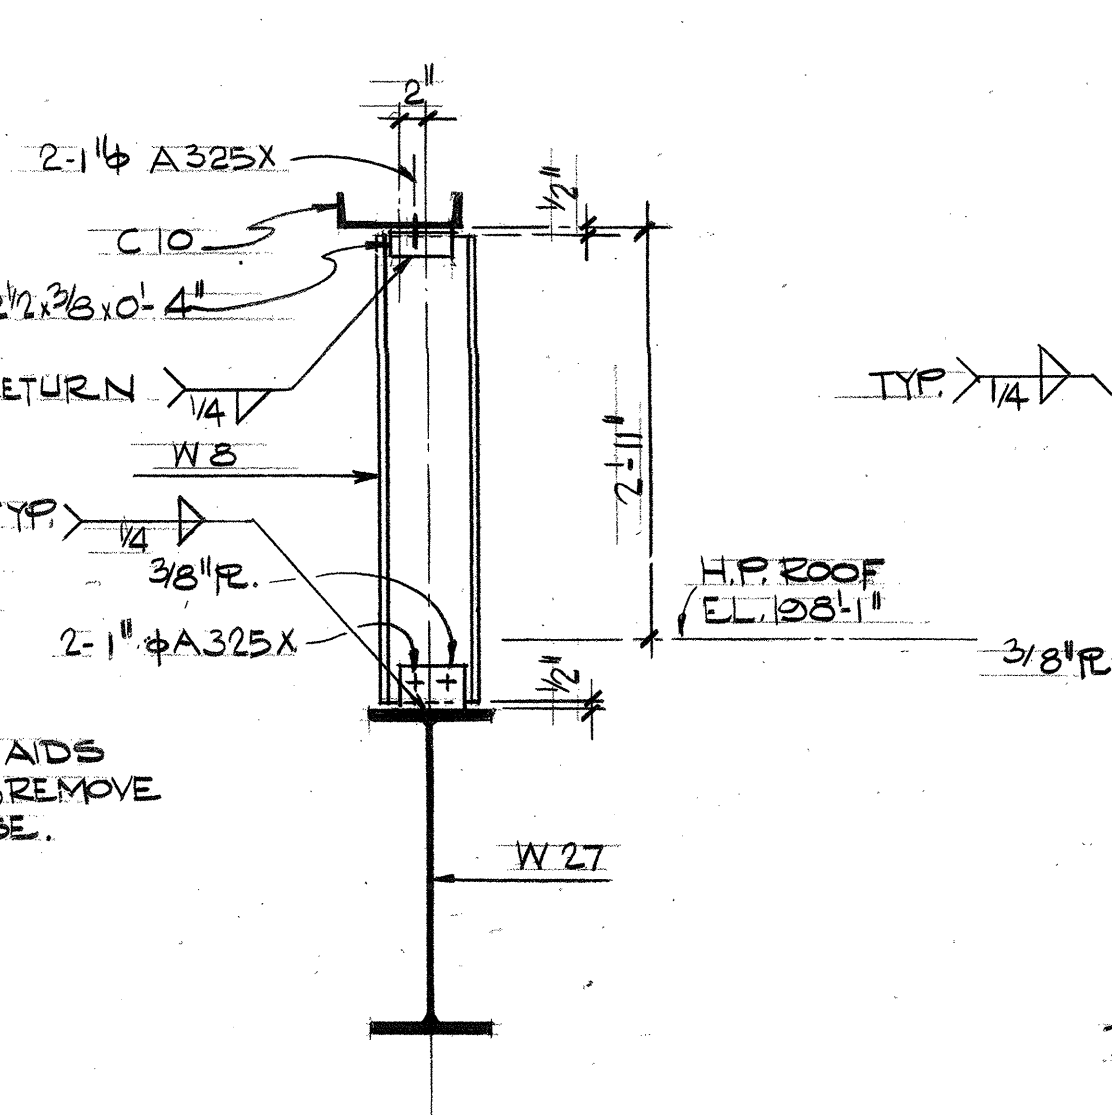
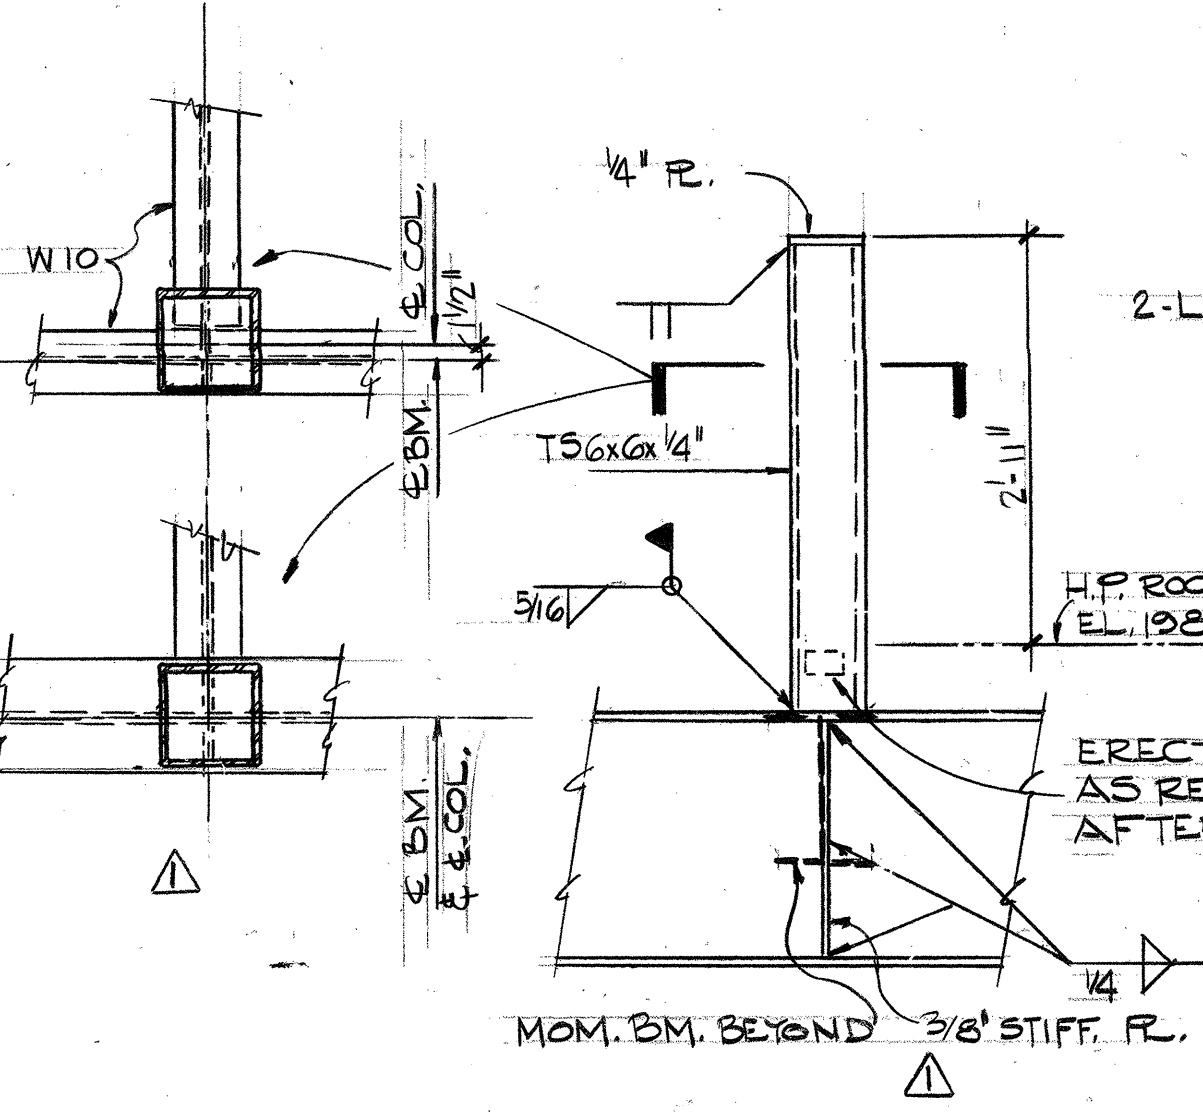


COL. LOCATION	C&S, C&T, C&B, C&I, C&J, C&K, C&L, C&M, C&N, C&O, C&P, C&Q, C&R, C&S, C&T, C&U, C&V, C&W, C&X, C&Y, C&Z	Q&S, Q&T	E&S, E&T, E&U, E&V, E&W, E&X, E&Y, E&Z	E&S, E&T
LEVEL				
ROOF	EL. 182'-8"			
LEVEL 8	EL. 182'-8"	W 14x90	W 14x90	W 14x90
LEVEL 7	EL. 169'-4"		W 14x90	W 14x90
LEVEL 6	EL. 156'-0"	W 14x90	W 14x90	W 14x90
LEVEL 5	EL. 142'-8"	W 14x90	W 14x90	W 14x90
LEVEL 4	EL. 129'-4"	W 14x90	W 14x90	W 14x90
LEVEL 3	EL. 116'-0"	W 14x90	W 14x90	W 14x90
LEVEL 2	GROUND FLOOR	W 14x90	W 14x90	W 14x90
LEVEL 1	BASEMENT			
TOP OF BASE R. ELEVATION	84'-1"	77'-1"	84'-1"	77'-1"
BASE R. SIZE	3/2 x 24 x 2'-6"	3/2 x 24 x 2'-6"	3/2 x 24 x 2'-6"	3/2 x 24 x 2'-6"
BASE R. DETAIL	2	3	3	3

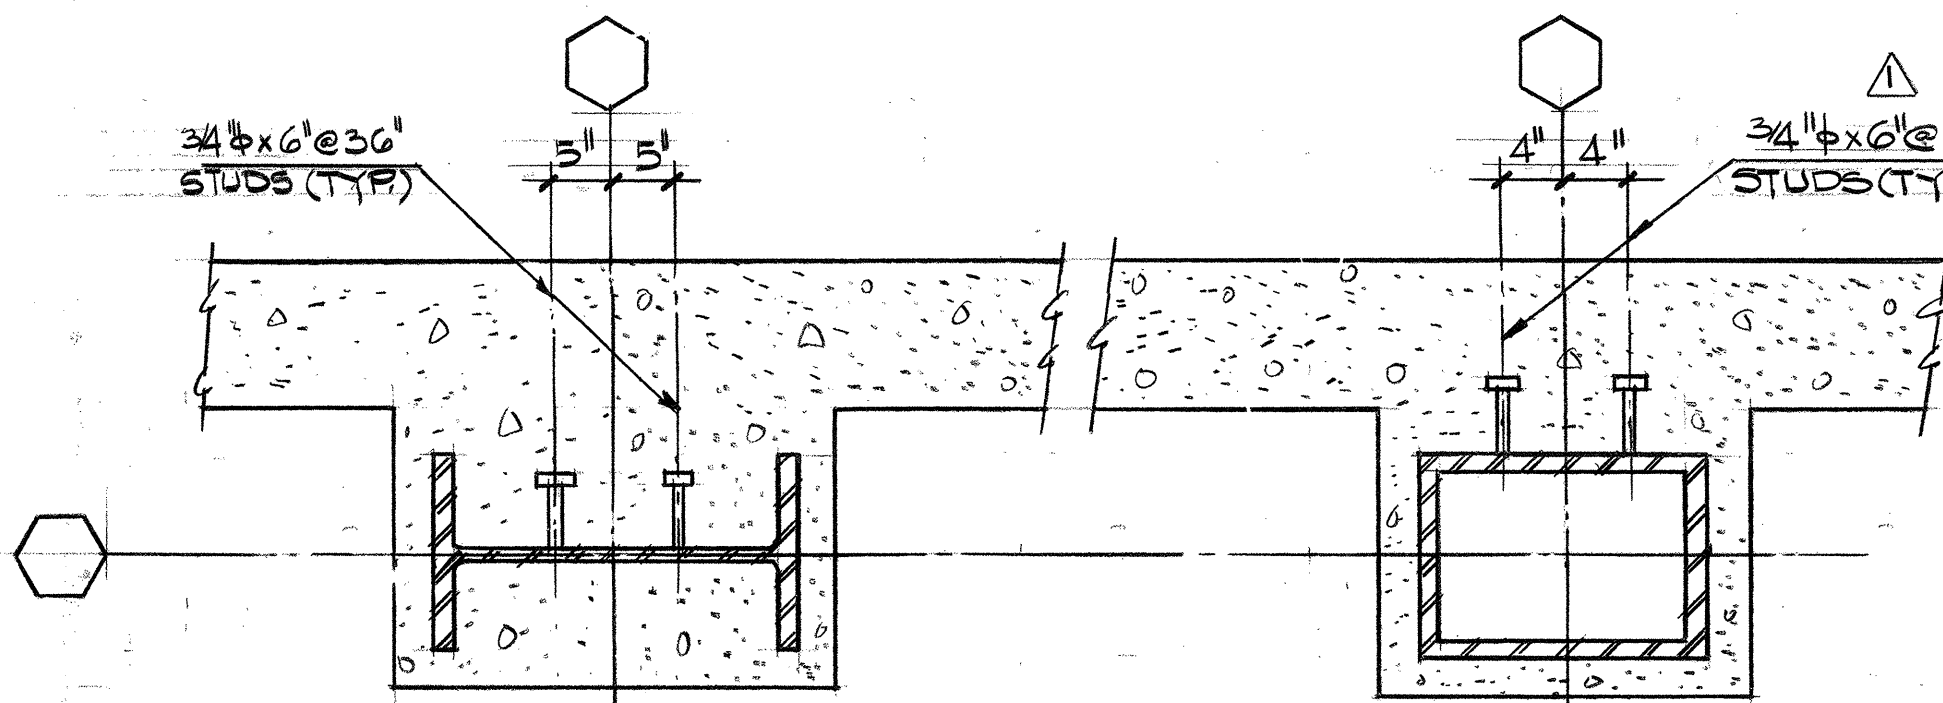

BEAM WT.	"D"	"B"	"E"	"W"
172	24	16	1/2	3/4
235	24	16	3/4	1
258	24	16	1	1
310	24	16	1 1/4	1 1/4
182	24	19	1/2	3/4
212	24	19	3/4	3/4
250	24	19	3/4	1
288	24	19	3/4	1 1/4

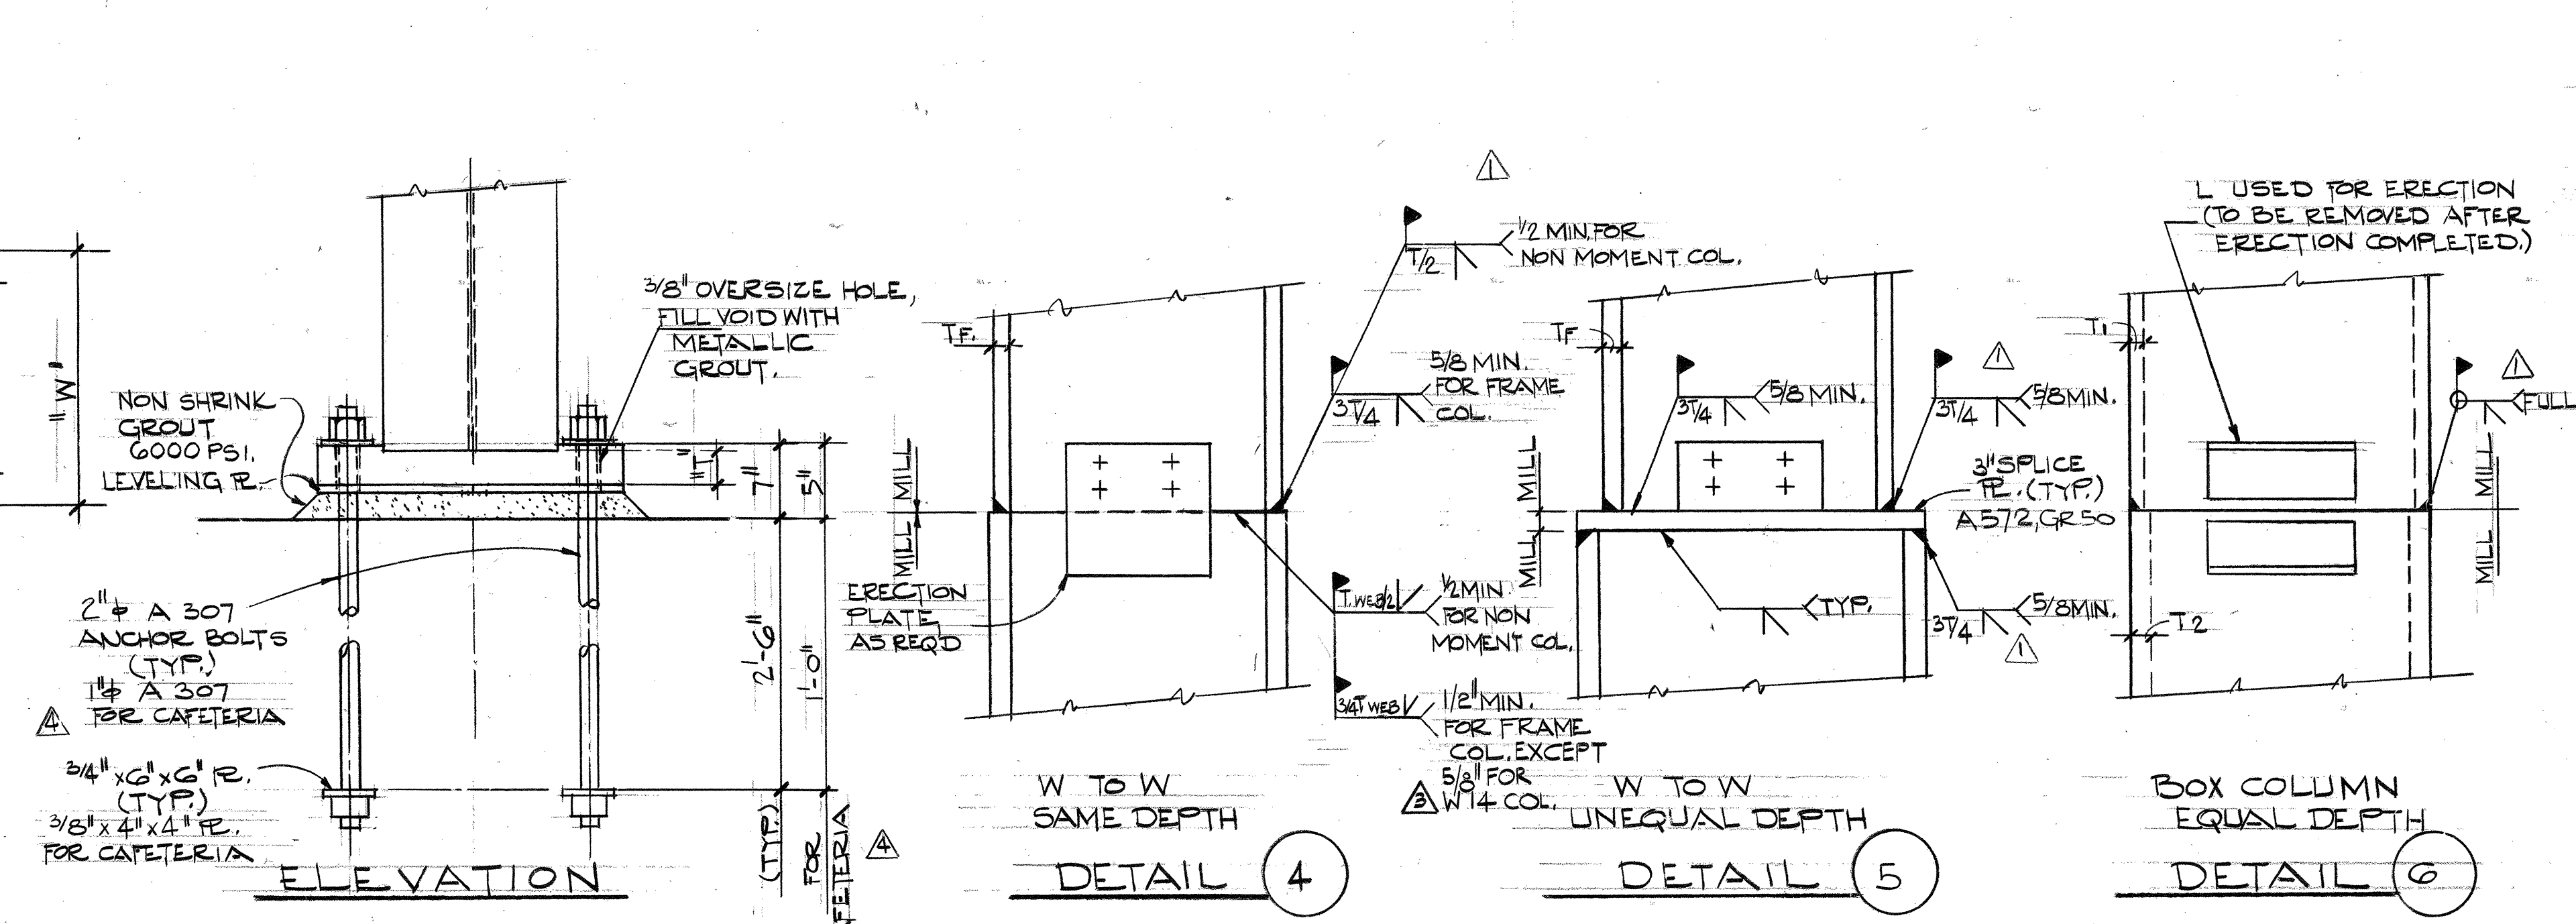

# Norwalk Building 43

Norwalk, California

Skidmore, Owings & Merrill  
Architects/Engineers  
One Maritime Plaza  
San Francisco, California

Jaros, Baum & Bolles  
Consulting Engineers  
345 Park Avenue  
New York, New York

Approved for the Owner by

Approved for the Architect by

Drawn by D. PALOTAS Job Number 10255-200

Checked by Date 9.3.81

Revisions

No.	Revisions Indicated this Δ:	Date
1	ISSUE FOR STRUCTURAL STEEL SCOPE BID	9.3.81
2	ISSUE FOR STRUCTURAL STEEL MILL ORDER ADDENDUM NO. 1	9.23.81
3	ADDENDUM NO. 2	10.1.81
4	ISSUE FOR STRUCTURAL STEEL DETAILING ADDENDUM NO. 4	10.28.81
5	ADDENDUM NO. 5	11.23.81
6	ADDENDUM NO. 15	1-15-82
7	FOR PLAN CHECK	1-29-82
8	ADDENDUM NO. 16	2-24-82
9	ISSUE FOR DETAILING ADDENDUM NO. 18	3-9-82
10	ADDENDUM NO. 17	4-30-82
11	ISSUED FOR PLAN CHECK	6-5-82

Ends B Type SE 1117

KEY PLAN

Frame Elevations & Column Schedule

Scale: none

S 16