

Norwalk  
Building 43

Norwalk, California

Skidmore, Owings & Merrill  
Architects/Engineers  
One Maritime Plaza  
San Francisco, California

Jaros, Baum & Bolles  
Consulting Engineers  
345 Park Avenue  
New York, New York

Approved for the Owner by

Approved for the Architect by


Drawn by D. PALOTAS Job Number 0205-200

Checked by Date

Revisions

No.	Revisions Indicated thus: Δ:	Date
	ISSUED FOR CONCRETE BID	
	ISSUED FOR FOUNDATION AND PILE PERMIT	12-2-81
Δ 1	ADDENDUM NO. 12	12-12-81
Δ 2	ADDENDUM NO. 13	12-29-81
	REVISION FOR PLAN CHECK	1-29-82
Δ 3	ADDENDUM NO. 26	2-24-82
Δ 4	ADDENDUM NO. 32	3-26-82
	ADDENDUM NO. 37 ISSUED FOR BUILDING PERMIT	4-30-82
Δ 5	ADDENDUM NO. 41	5-17-82
Δ 6	ADDENDUM NO. 49	6-23-82
Δ 7	ADDENDUM NO. 72	9-7-82
Δ 8	ADDENDUM NO. 92	11-24-82
Δ 9	ADDENDUM NO. 135	7-11-83

SEAL  
KEY PLAN

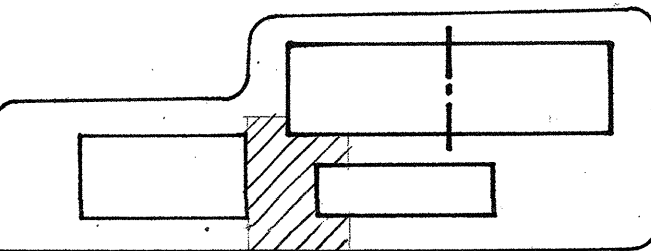

TRUCK DOCK /  
SERVICE AREA


Ground Floor

Framing Plan

Basement Plan

Scale: 1/8"=1'-0"

S 22

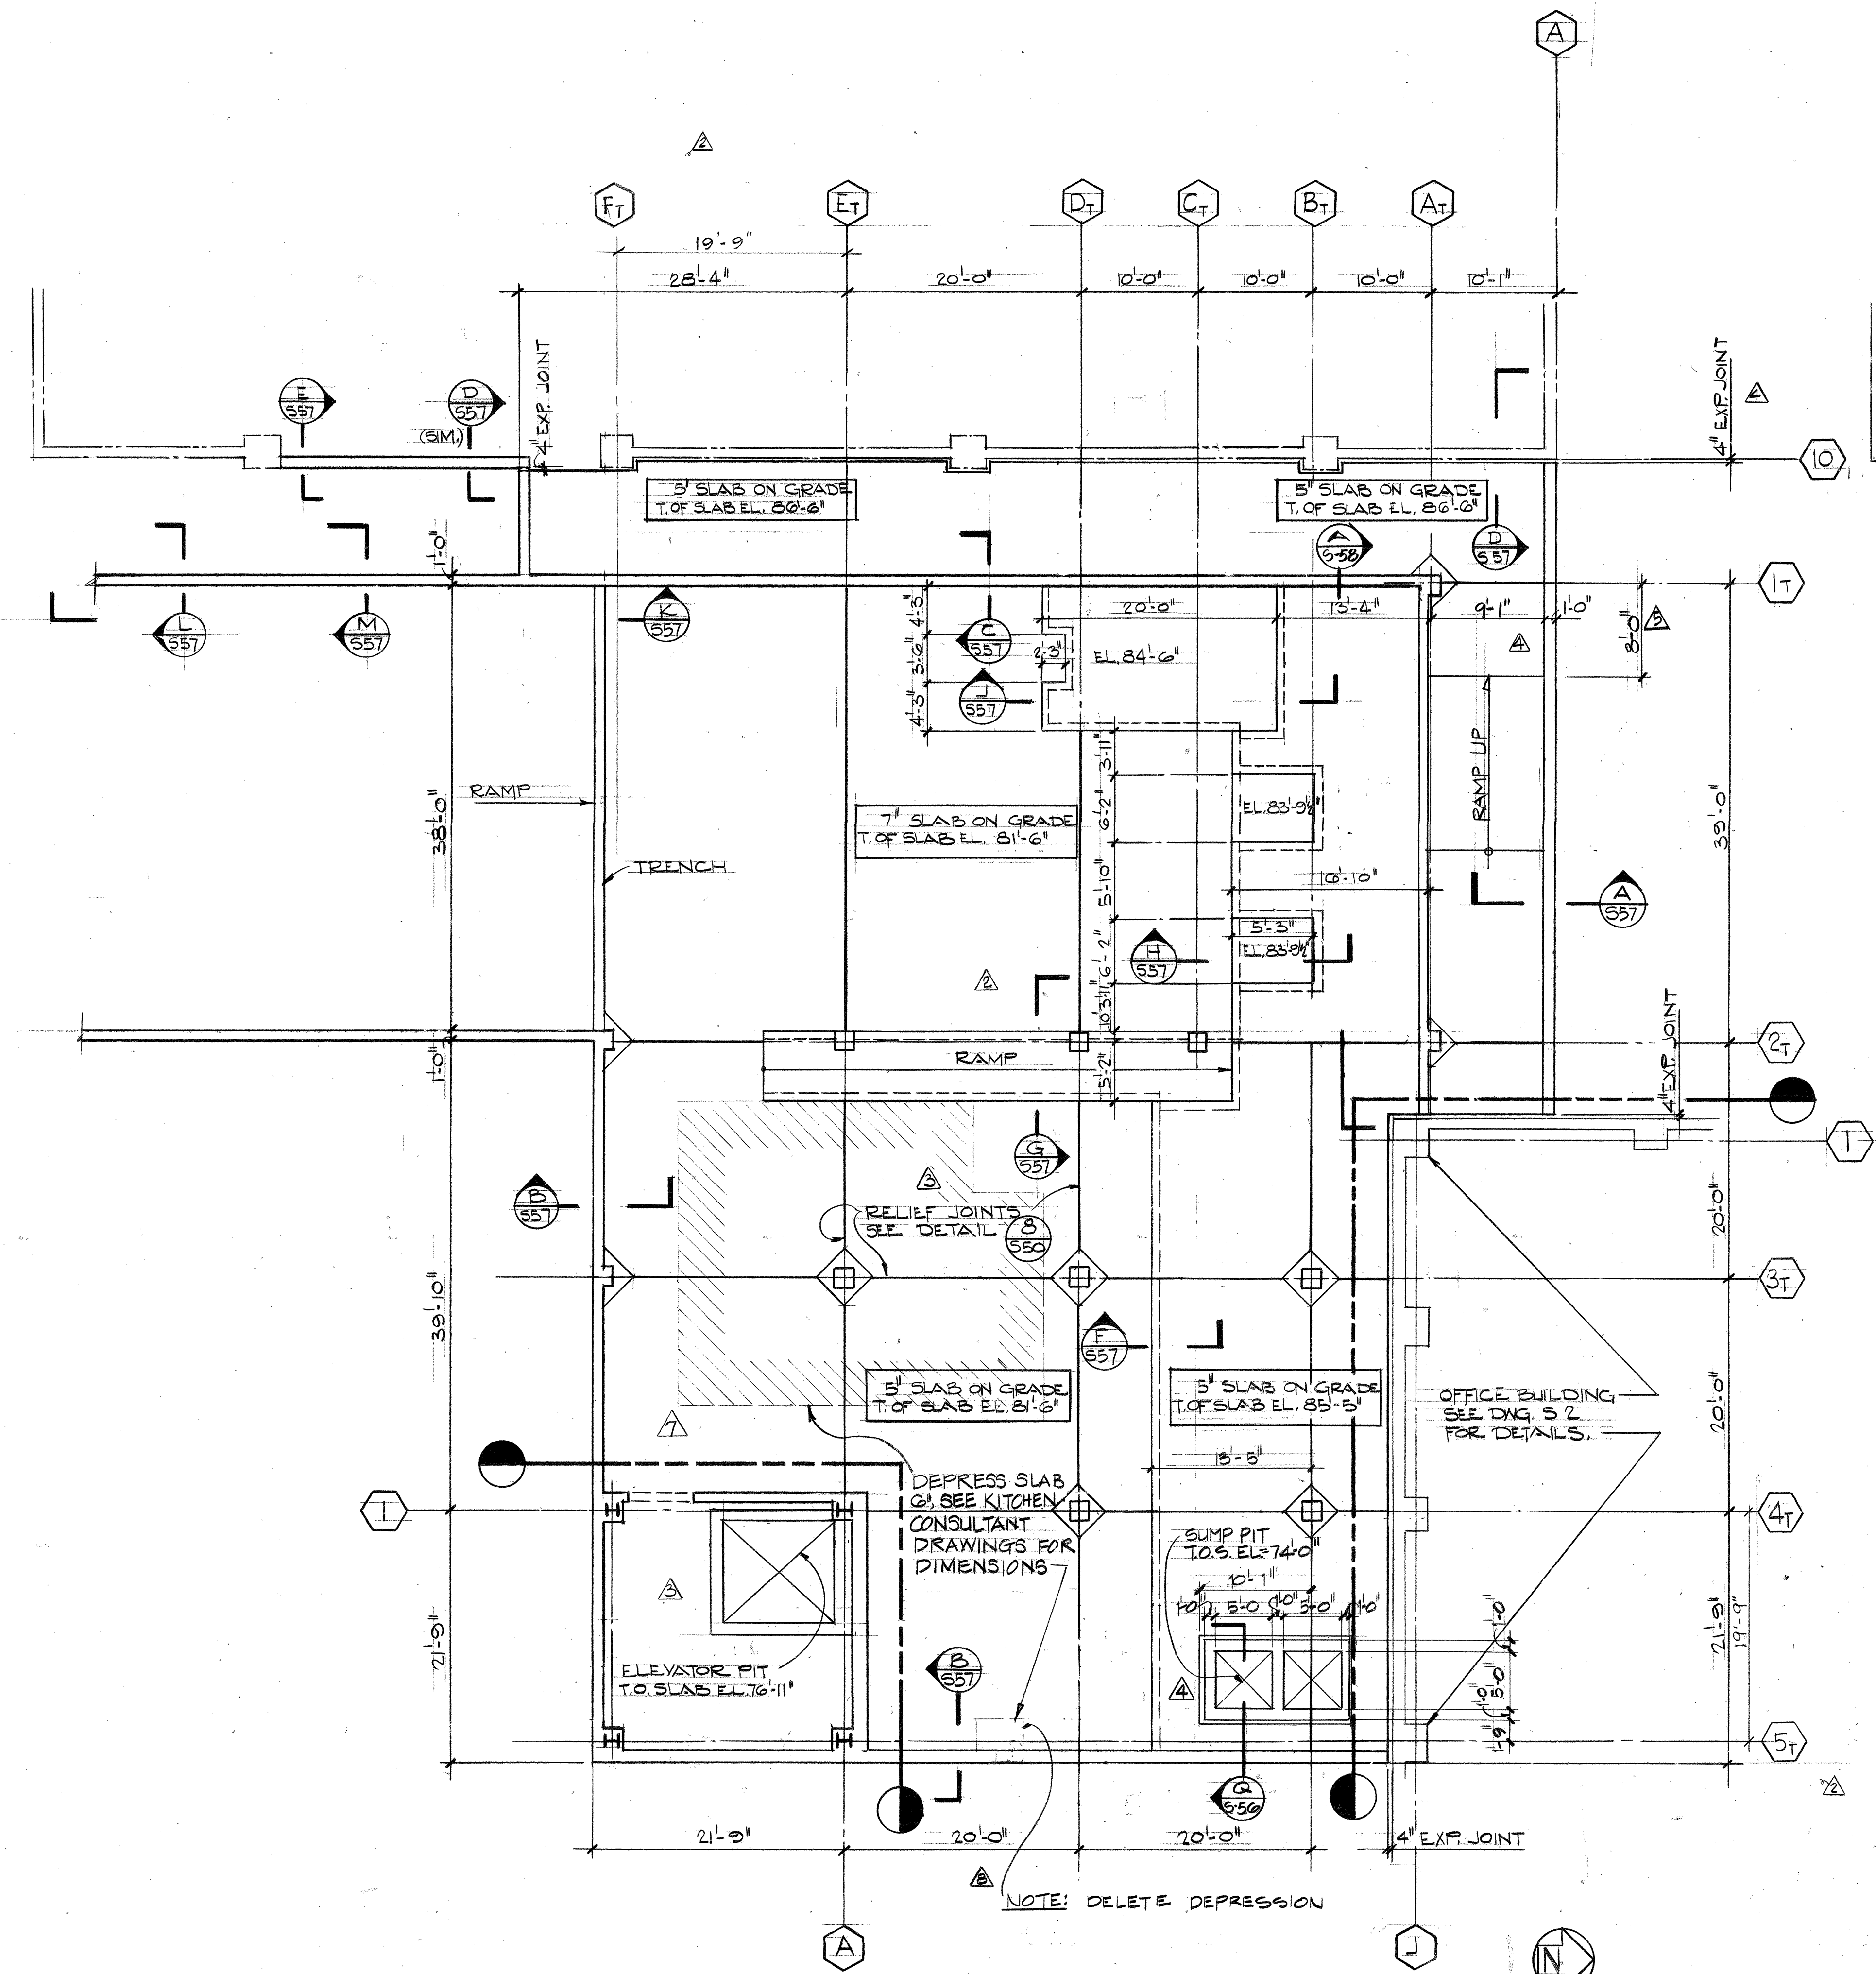


BASEMENT PLAN

1. REINFORCE 5' SLAB ON GRADE WITH #4 @ 12" C/CW AT MID-DEPTH. REINFORCE 7' SLAB ON GRADE WITH #5 @ 12" C/CW AT MID-DEPTH.

DESIGN LOADS

GROUND FLOOR	PSF.
5' PAVEMENT	65
2" SAND	20
8" R.W. CONC. SLAB	100
CEILING	100
MISC.	200
DEAD LOAD	190
PLANTING AND/OR LIVE LOAD	300

LOAD CAPACITY FOR DESIGN ONLY.  
NOT FOR CONSTRUCTION.

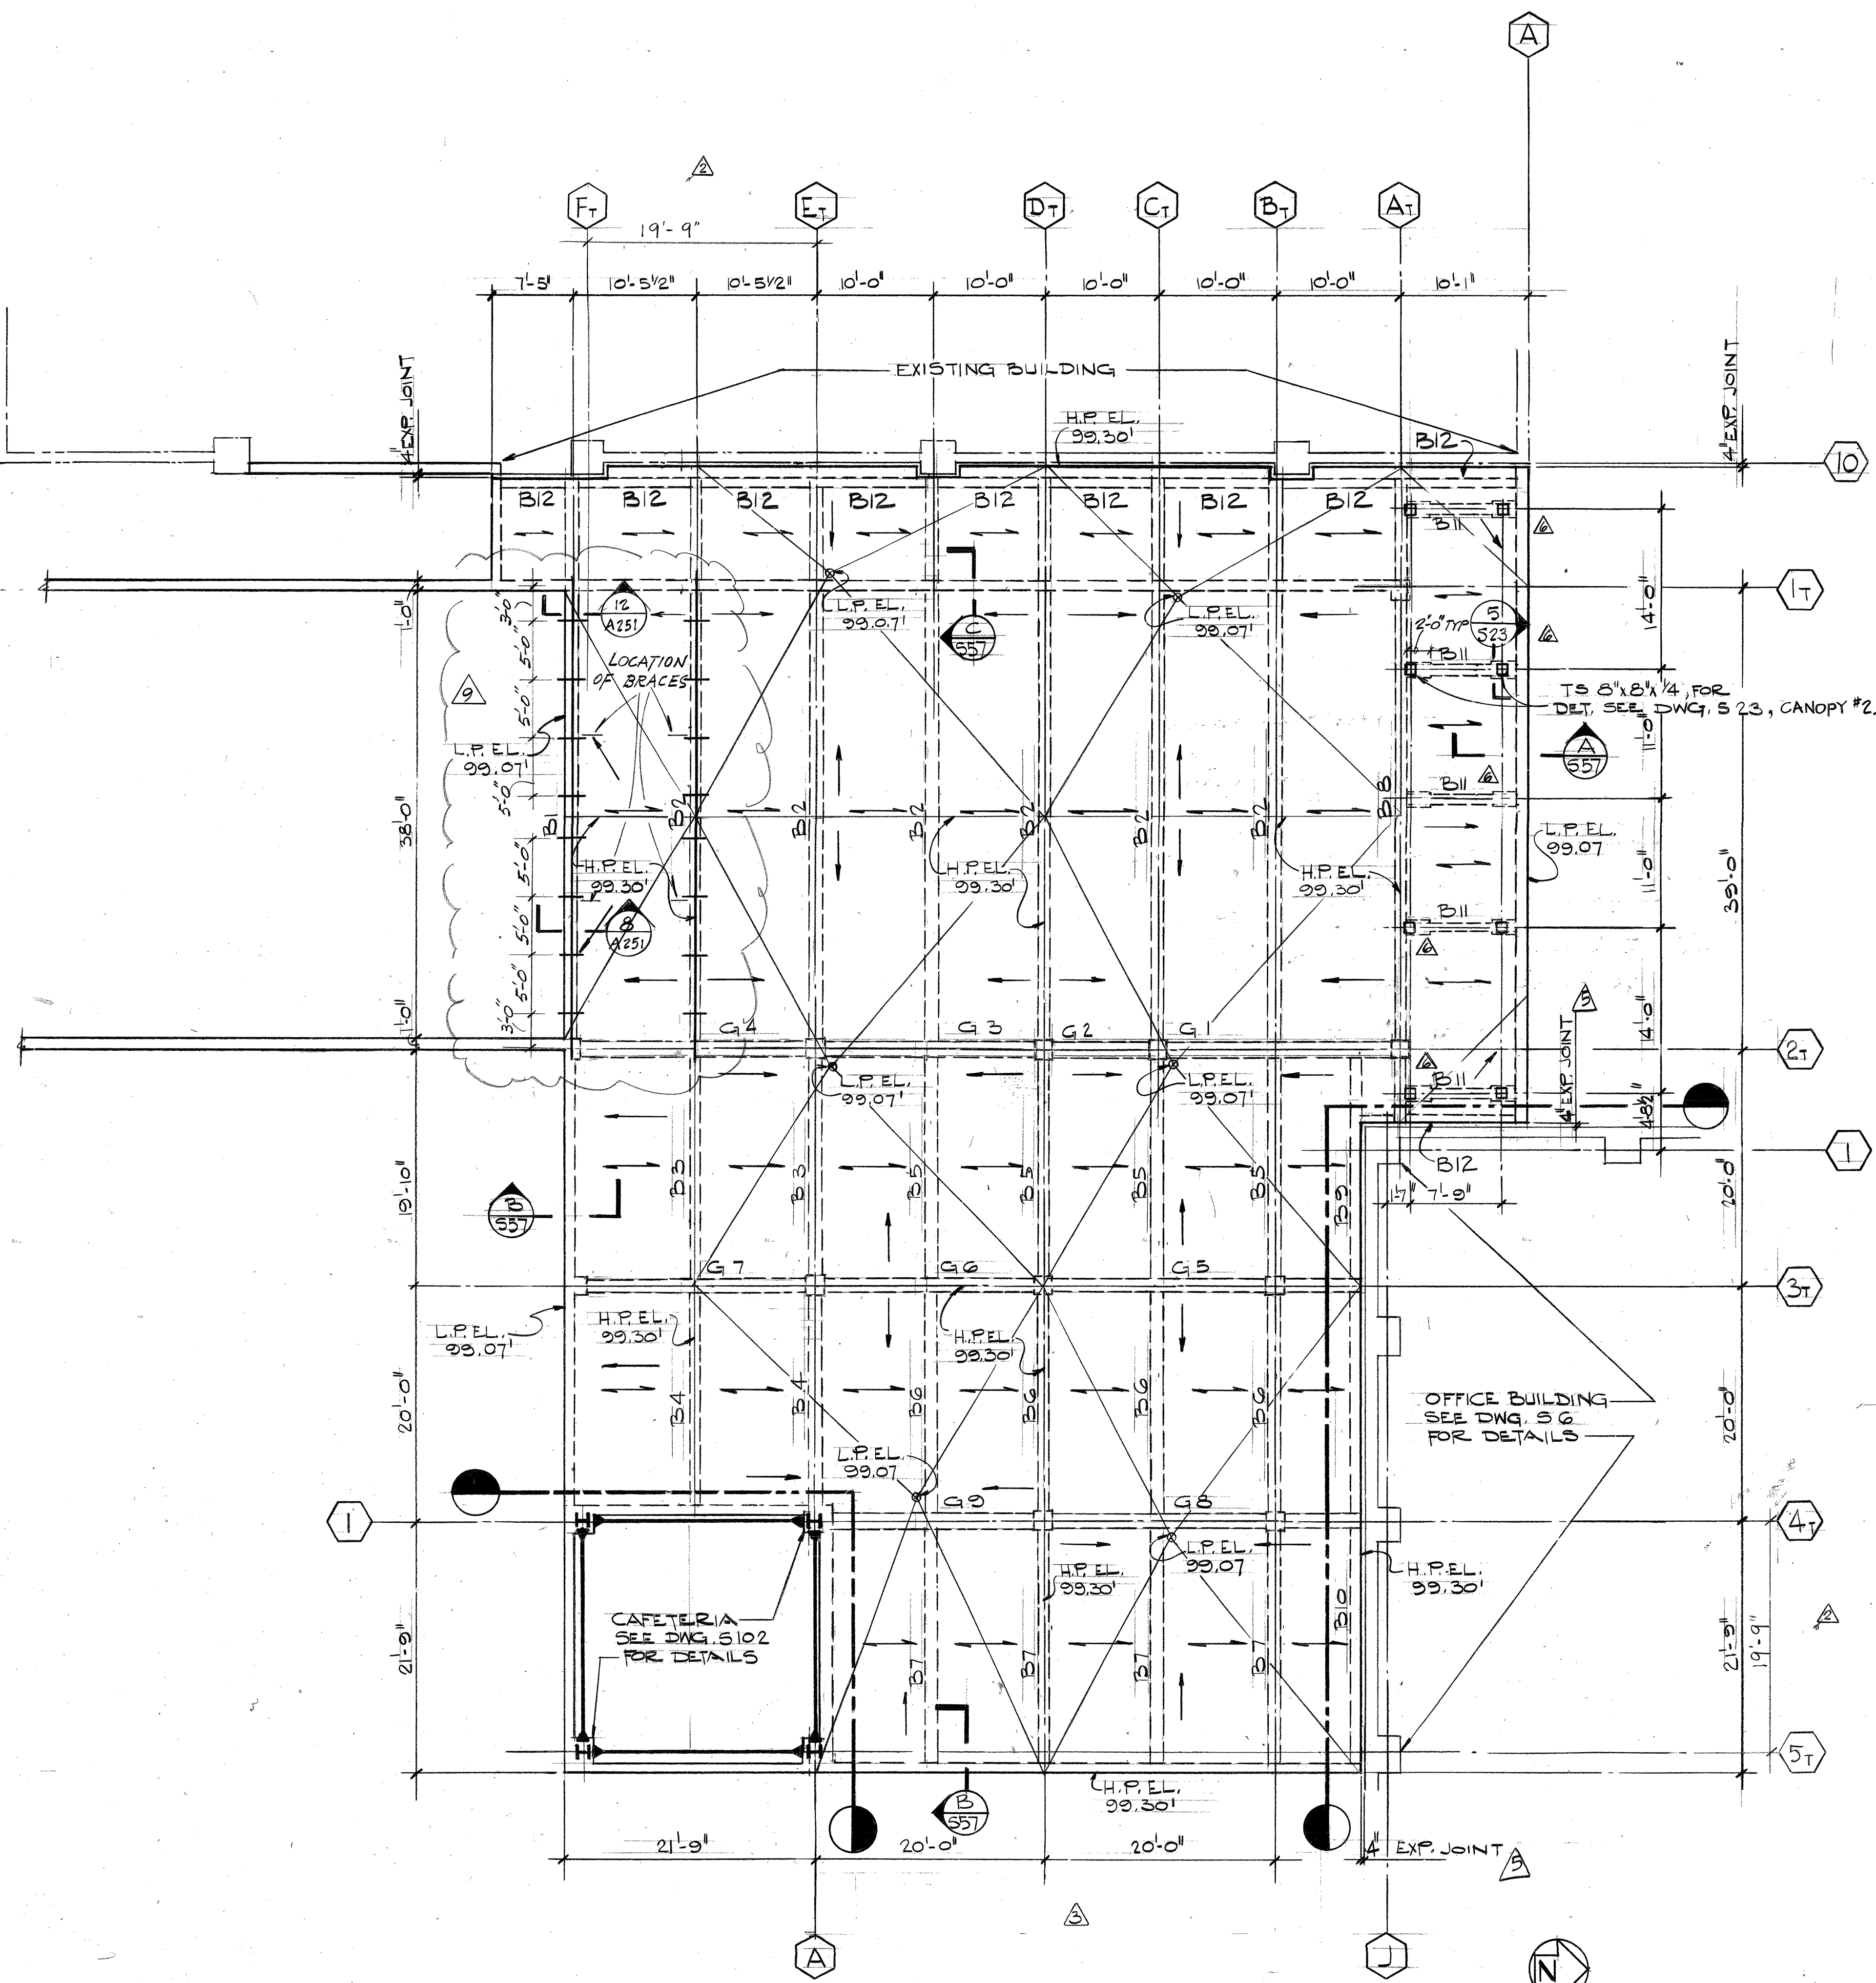

GROUND FLOOR FRAMING PLAN

1. FOR BEAMS, GIRDERS & COLUMNS SEE (S21)  
2. ELEVATIONS SHOWN INDICATES TOP OF N.W. CONC. FILL  
ELEVATIONS, SEE DET. C/S 21 FOR SLAB DETAIL  
3. FOR PLANTER WALL DOVELLS SEE ARCH. DWGS.