

Norwalk, California

Skidmore, Owings & Merrill
Architects/Engineers
One Maritime Plaza
San Francisco, California

Jaros, Baum & Bolles
Consulting Engineers
345 Park Avenue
New York, New York

Approved for the Owner by _____

Approved for the Architect by _____


Drawn by D. PALOTAS	Job Number 6293-200
Checked by	Date

Revisions

o.	Revisions indicated thus Δ:	Date
	ADDENDUM No. 2	10-7-81
	ISSUE FOR STRUCTURAL STEEL DETAILING ADDENDUM NO. 4	10-28-81
	ISSUED FOR PLAN CHECK	1-29-82
	ADDENDUM NO. 37	4-10-82
	ISSUED FOR BUILDING PERMIT	
Δ	ADDENDUM NO. 43	5-21-82

Ente B. Taylor SE 1117


KEY PLAN

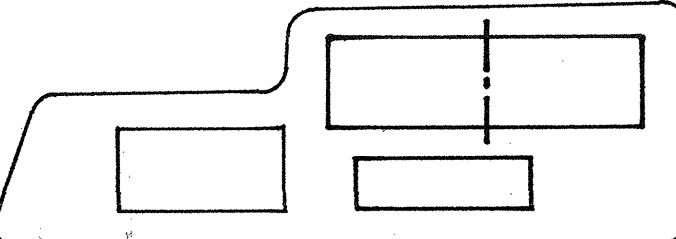

Miscellaneous Steel Details 2

Scale : as noted

S 33

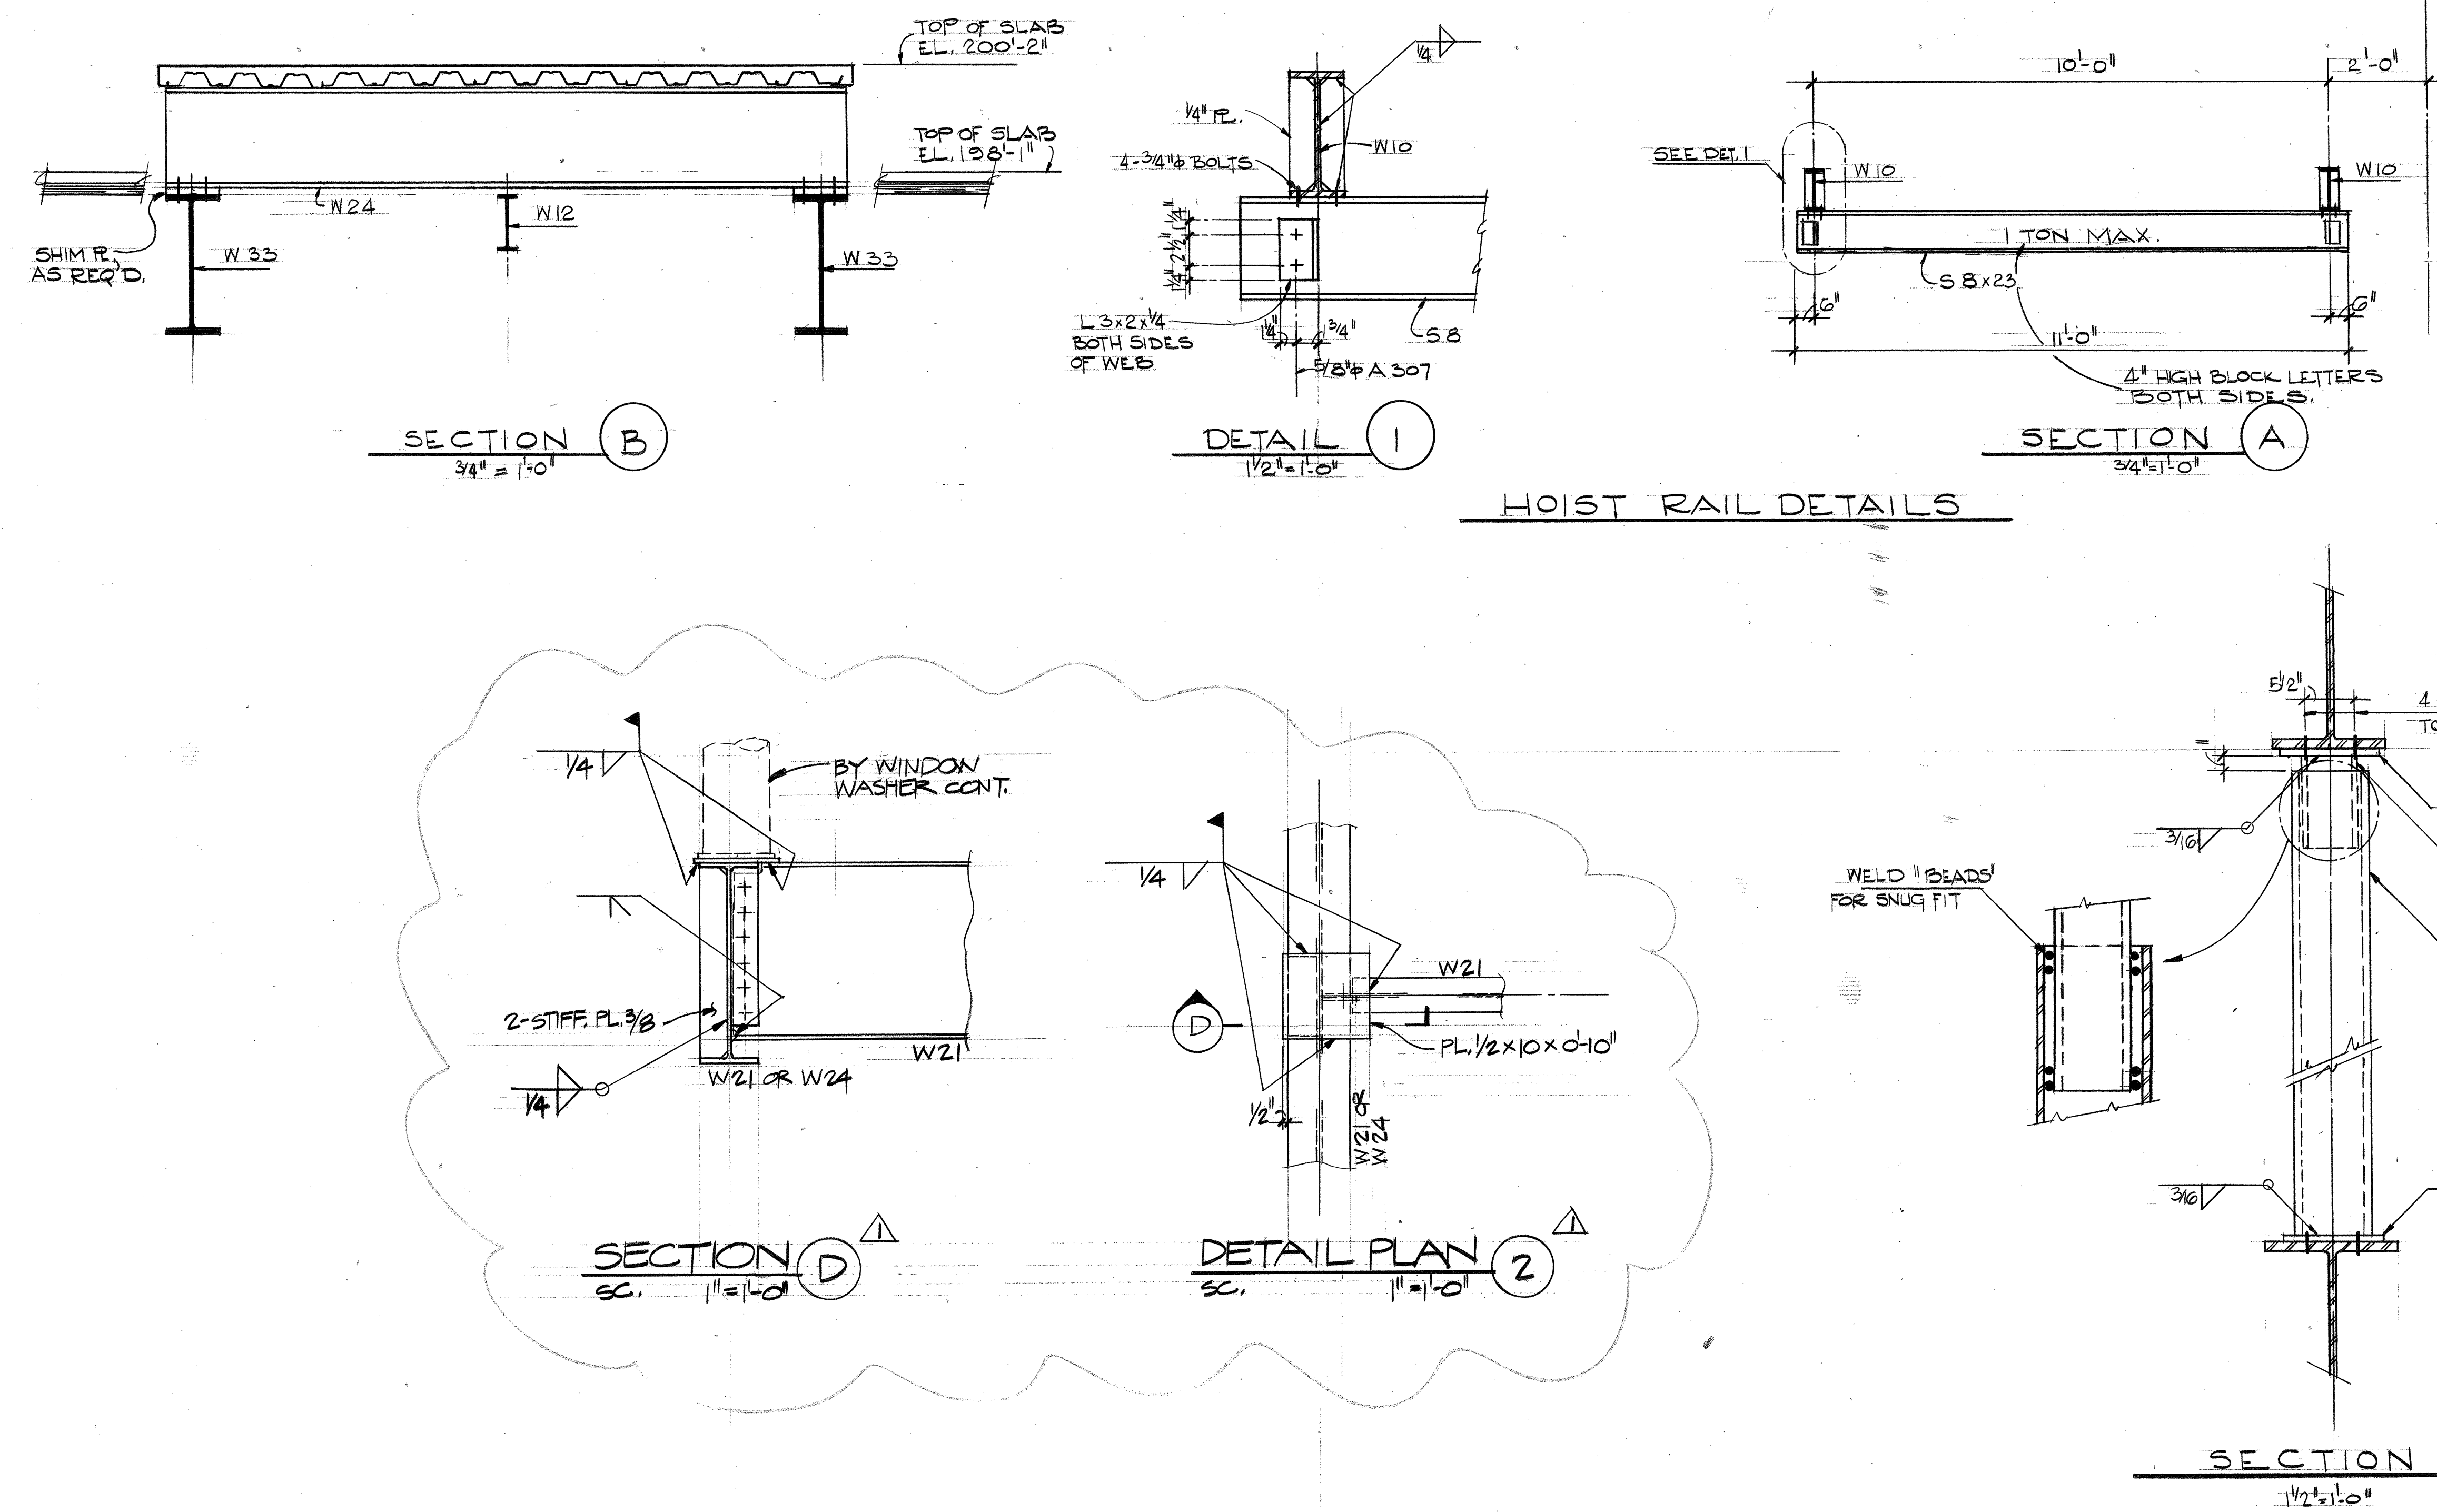

S 33