

Approved for the Owner by

Approved for the Architect by

Drawn by D. PALOTAS Job Number 10233-200


Checked by Date

Revisions

No.	Revisions Indicated thus Δ:	Date
1	ISSUED FOR FILE BID	11-23-81
2	ISSUED FOR CONCRETE BID	
3	ISSUED FOR FOUNDATION & PILE PERMIT	12-8-81
4	ADDENDUM NO. 12	12-16-81
5	ISSUED FOR PLAN CHECK	1-27-82
6	ADDENDUM NO. 26	2-24-82
7	ADDENDUM NO. 32	5-7-82
8	ADDENDUM NO. 36	4-16-82
9	ADDENDUM NO. 37	4-30-82
10	ADDENDUM NO. 60	7-23-82

SE 11.17

KEY PLAN


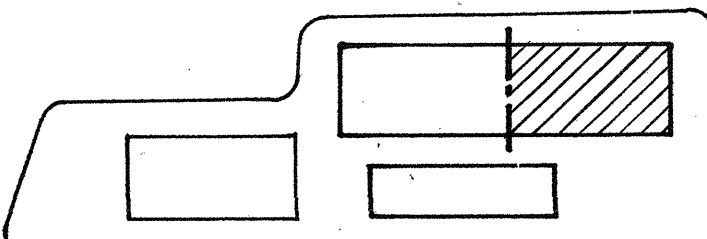


N

Foundation Plan /
East

Scale 1/8" = 1'-0"

S 1

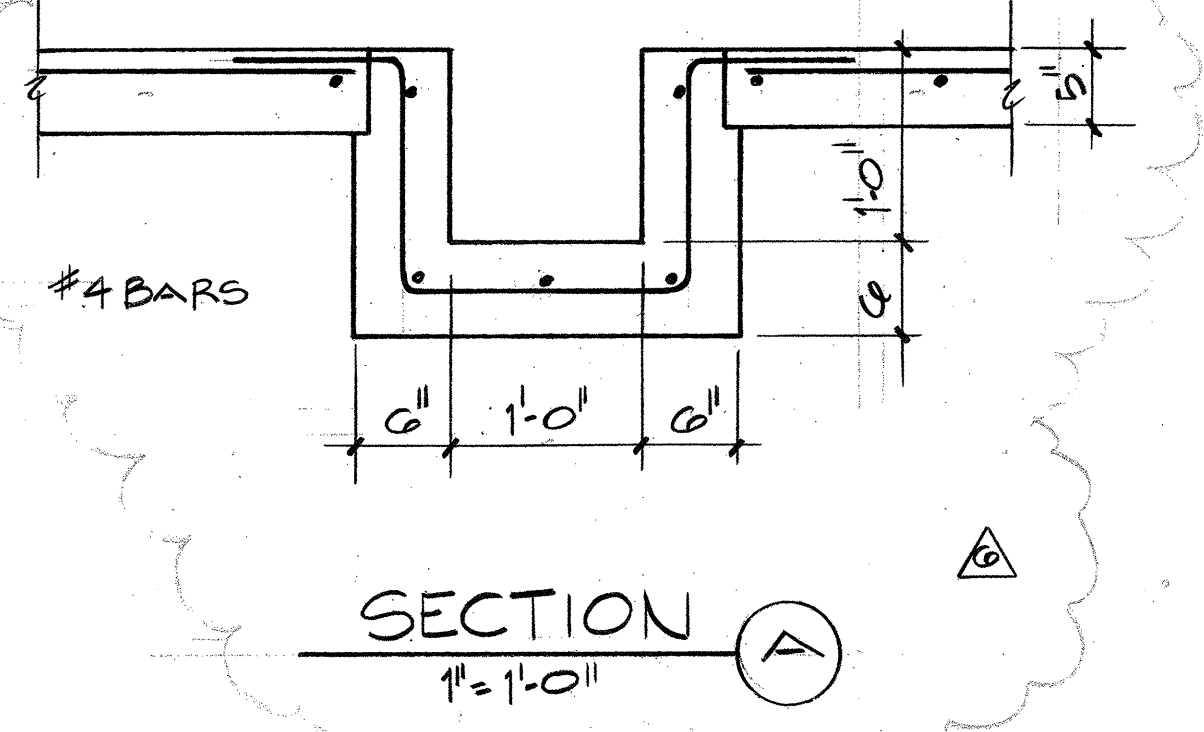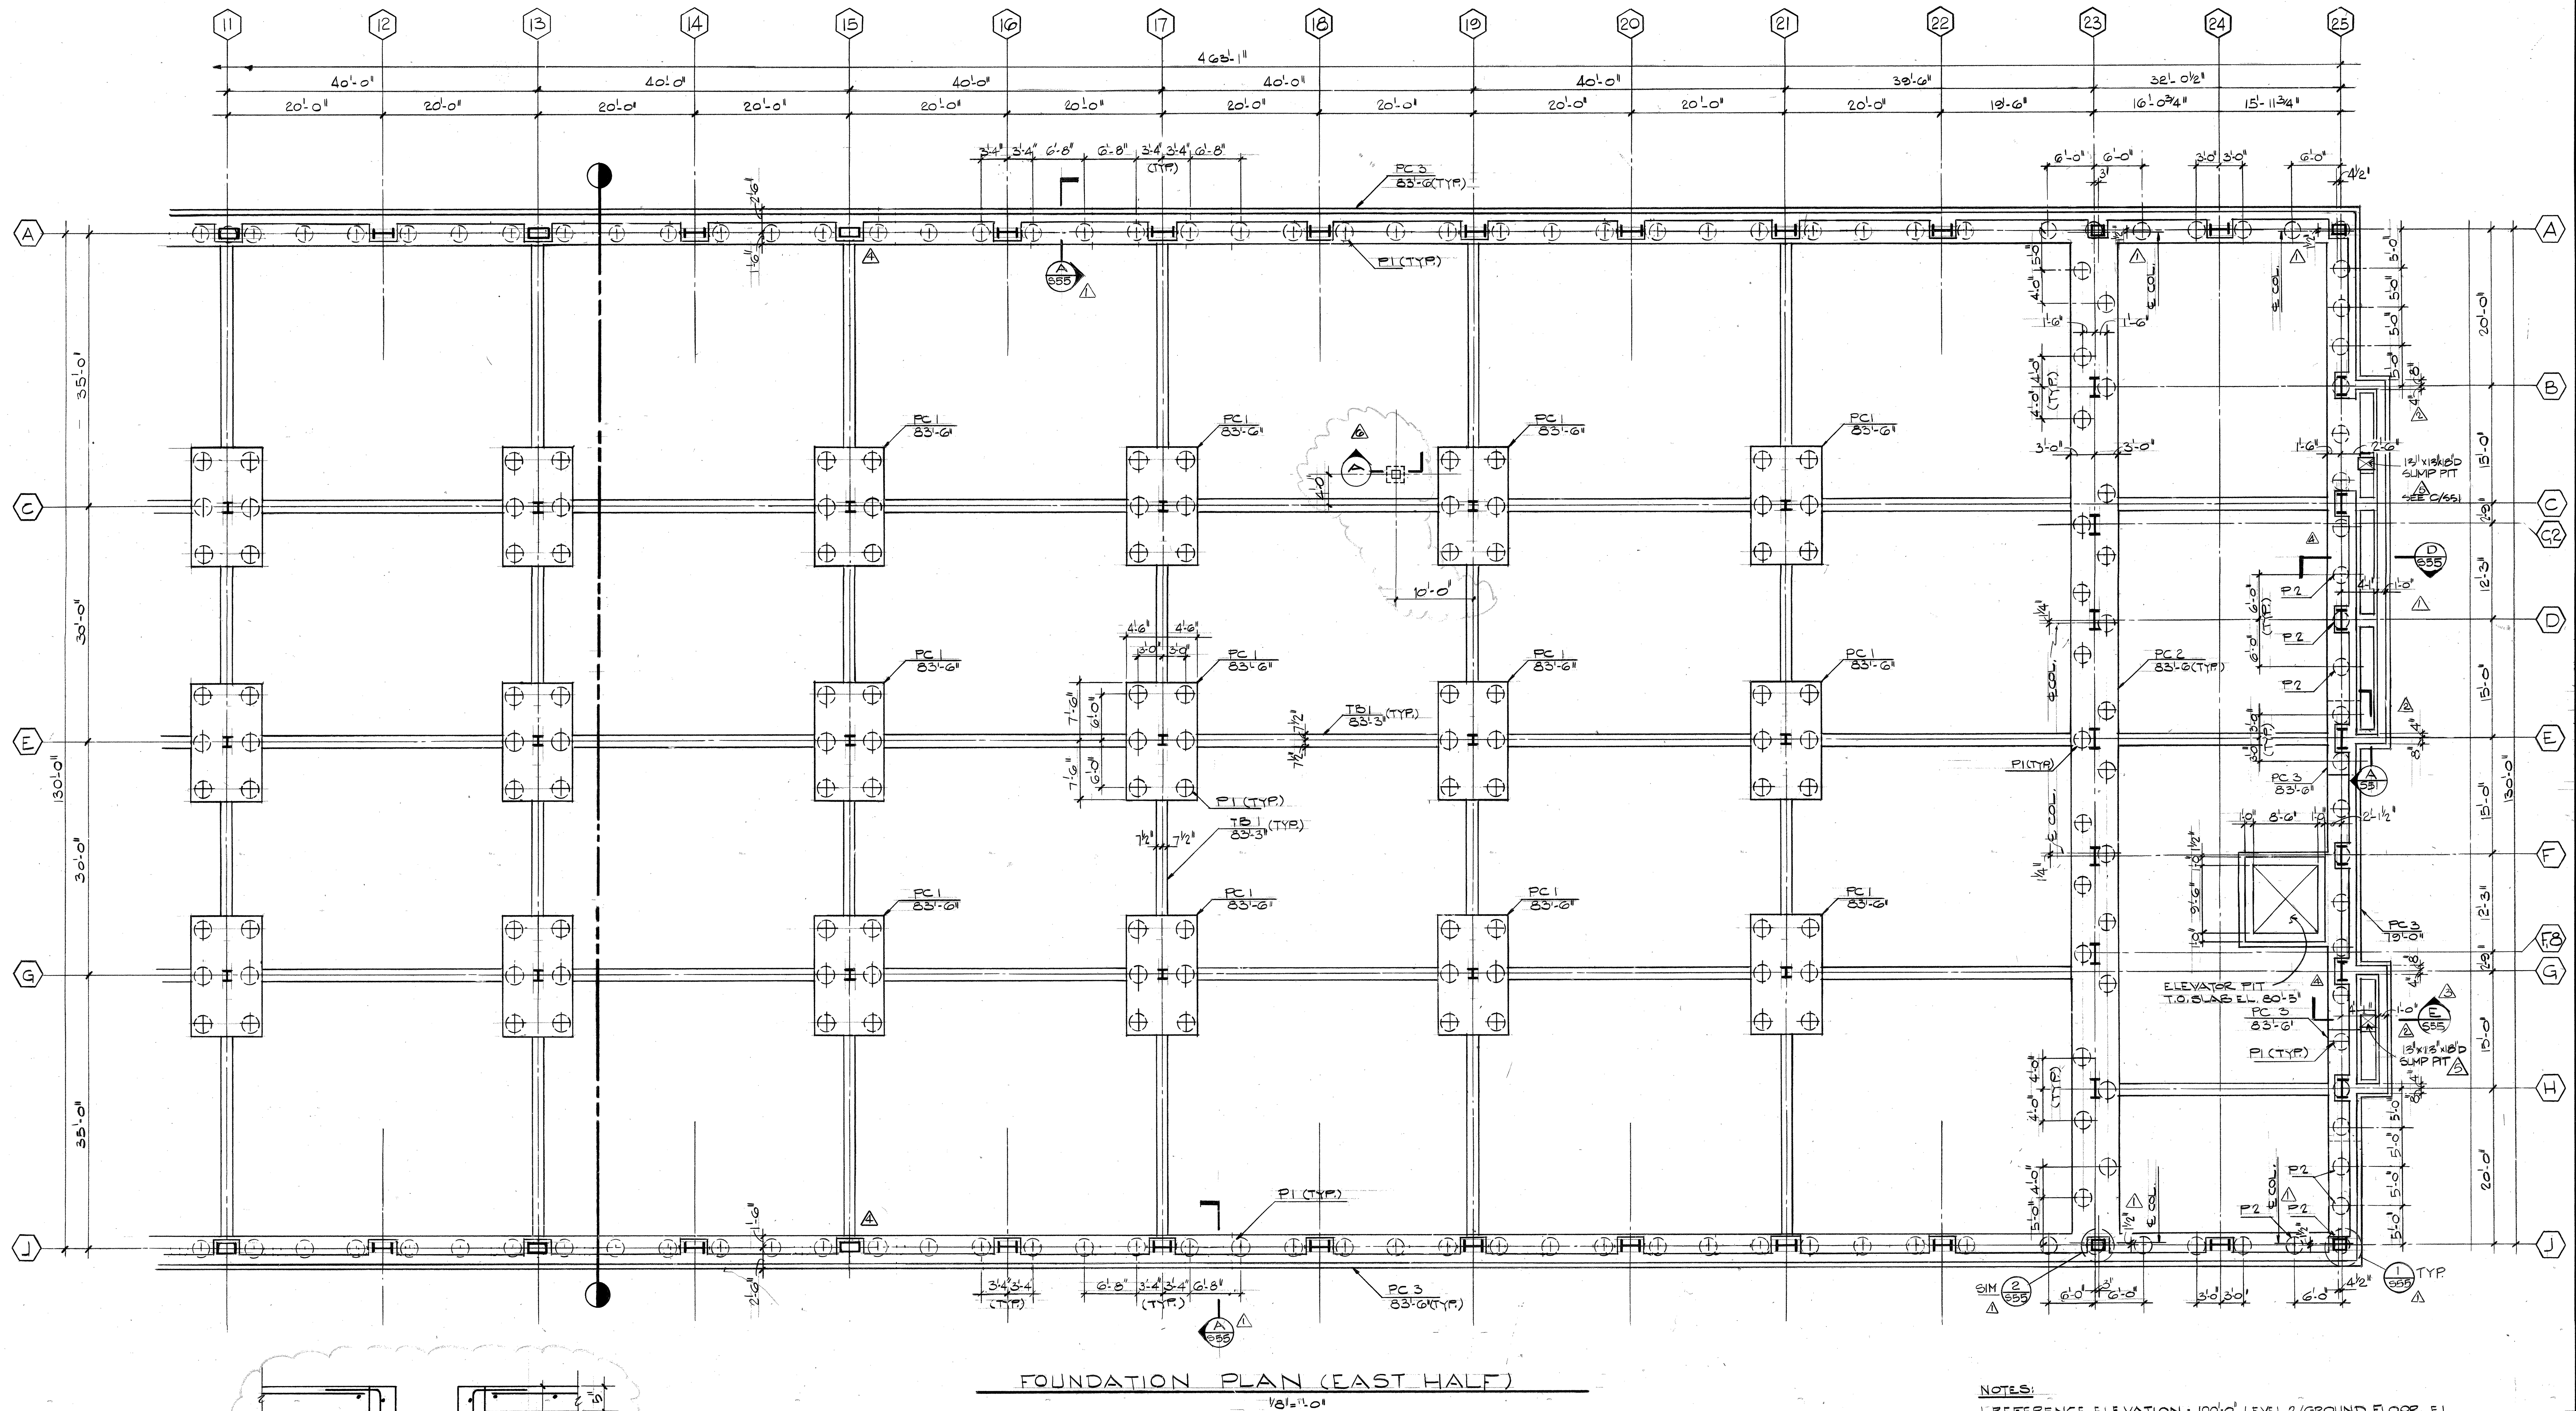

- NOTES:
1. REFERENCE ELEVATION = 100'-0" LEVEL 2/GROUND FLOOR EL.
 2. FOR GENERAL NOTES SEE 50
 3. FOR TYPICAL CONCRETE DETAILS SEE 55
 4. FOR PILE AND FOOTING DETAILS SEE 55
 5. PC 1 83'-6" INDICATES EL. TOP OF PILE CAP.