



CAFETERIA  
PENTHOUSE ROOF PLAN  
1/8" = 1'-0"

| DESIGN LOADS                           |     |
|--|-----|
| TYPICAL                                | PSF |
| 2" MIN. CONC. FILL<br>ON 3" METAL DECK | 53  |
| CEILING                                | 5   |
| ROOFING & INSUL.                       | 10  |
| TILE ROOF, G.MISC.                     | 5   |
| DEAD LOAD                              | 73  |
| LIVE LOAD (1)                          | 20  |
| (1) NOT REDUCED                        |     |


LOAD CAPACITIES FOR DESIGN ONLY  
NOT FOR CONSTRUCTION

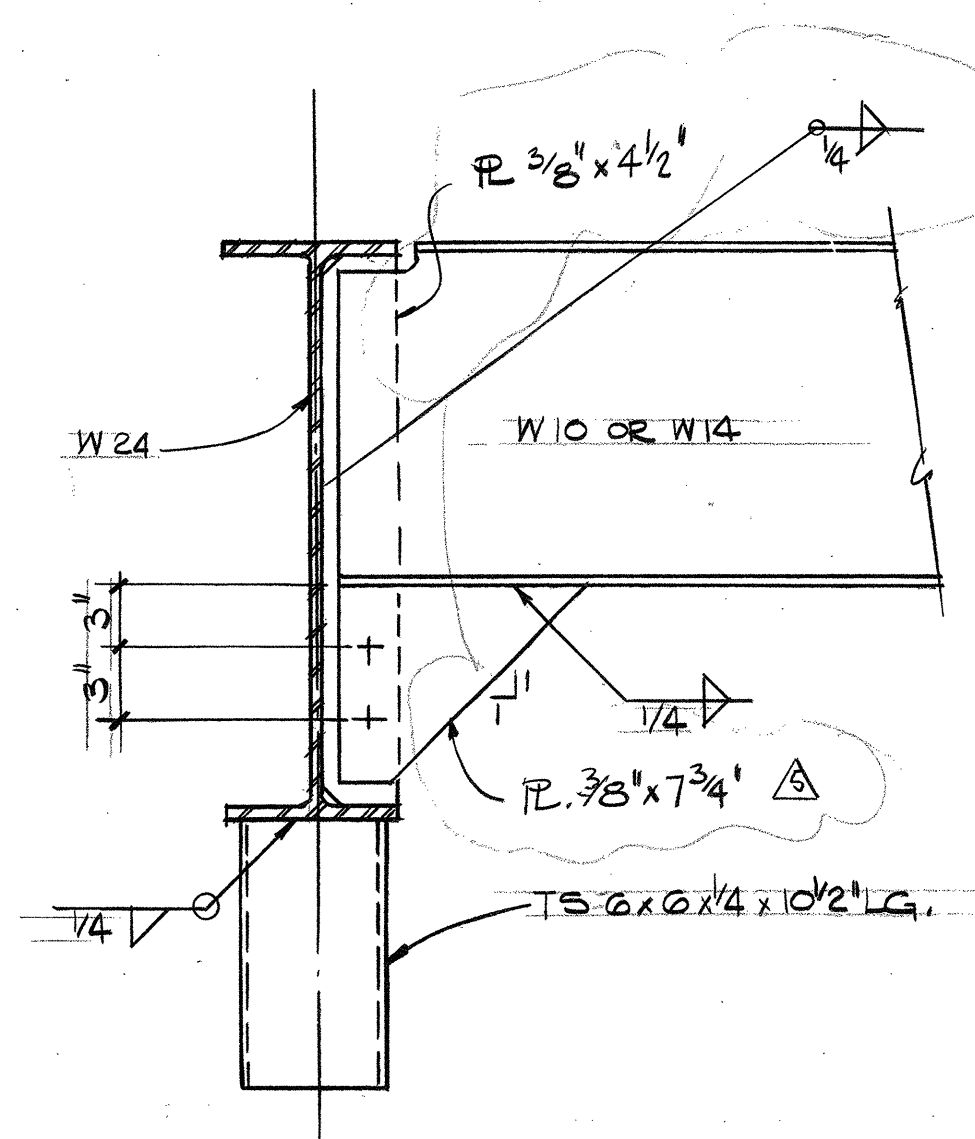


DETAIL 1  
1/2" = 1'-0"

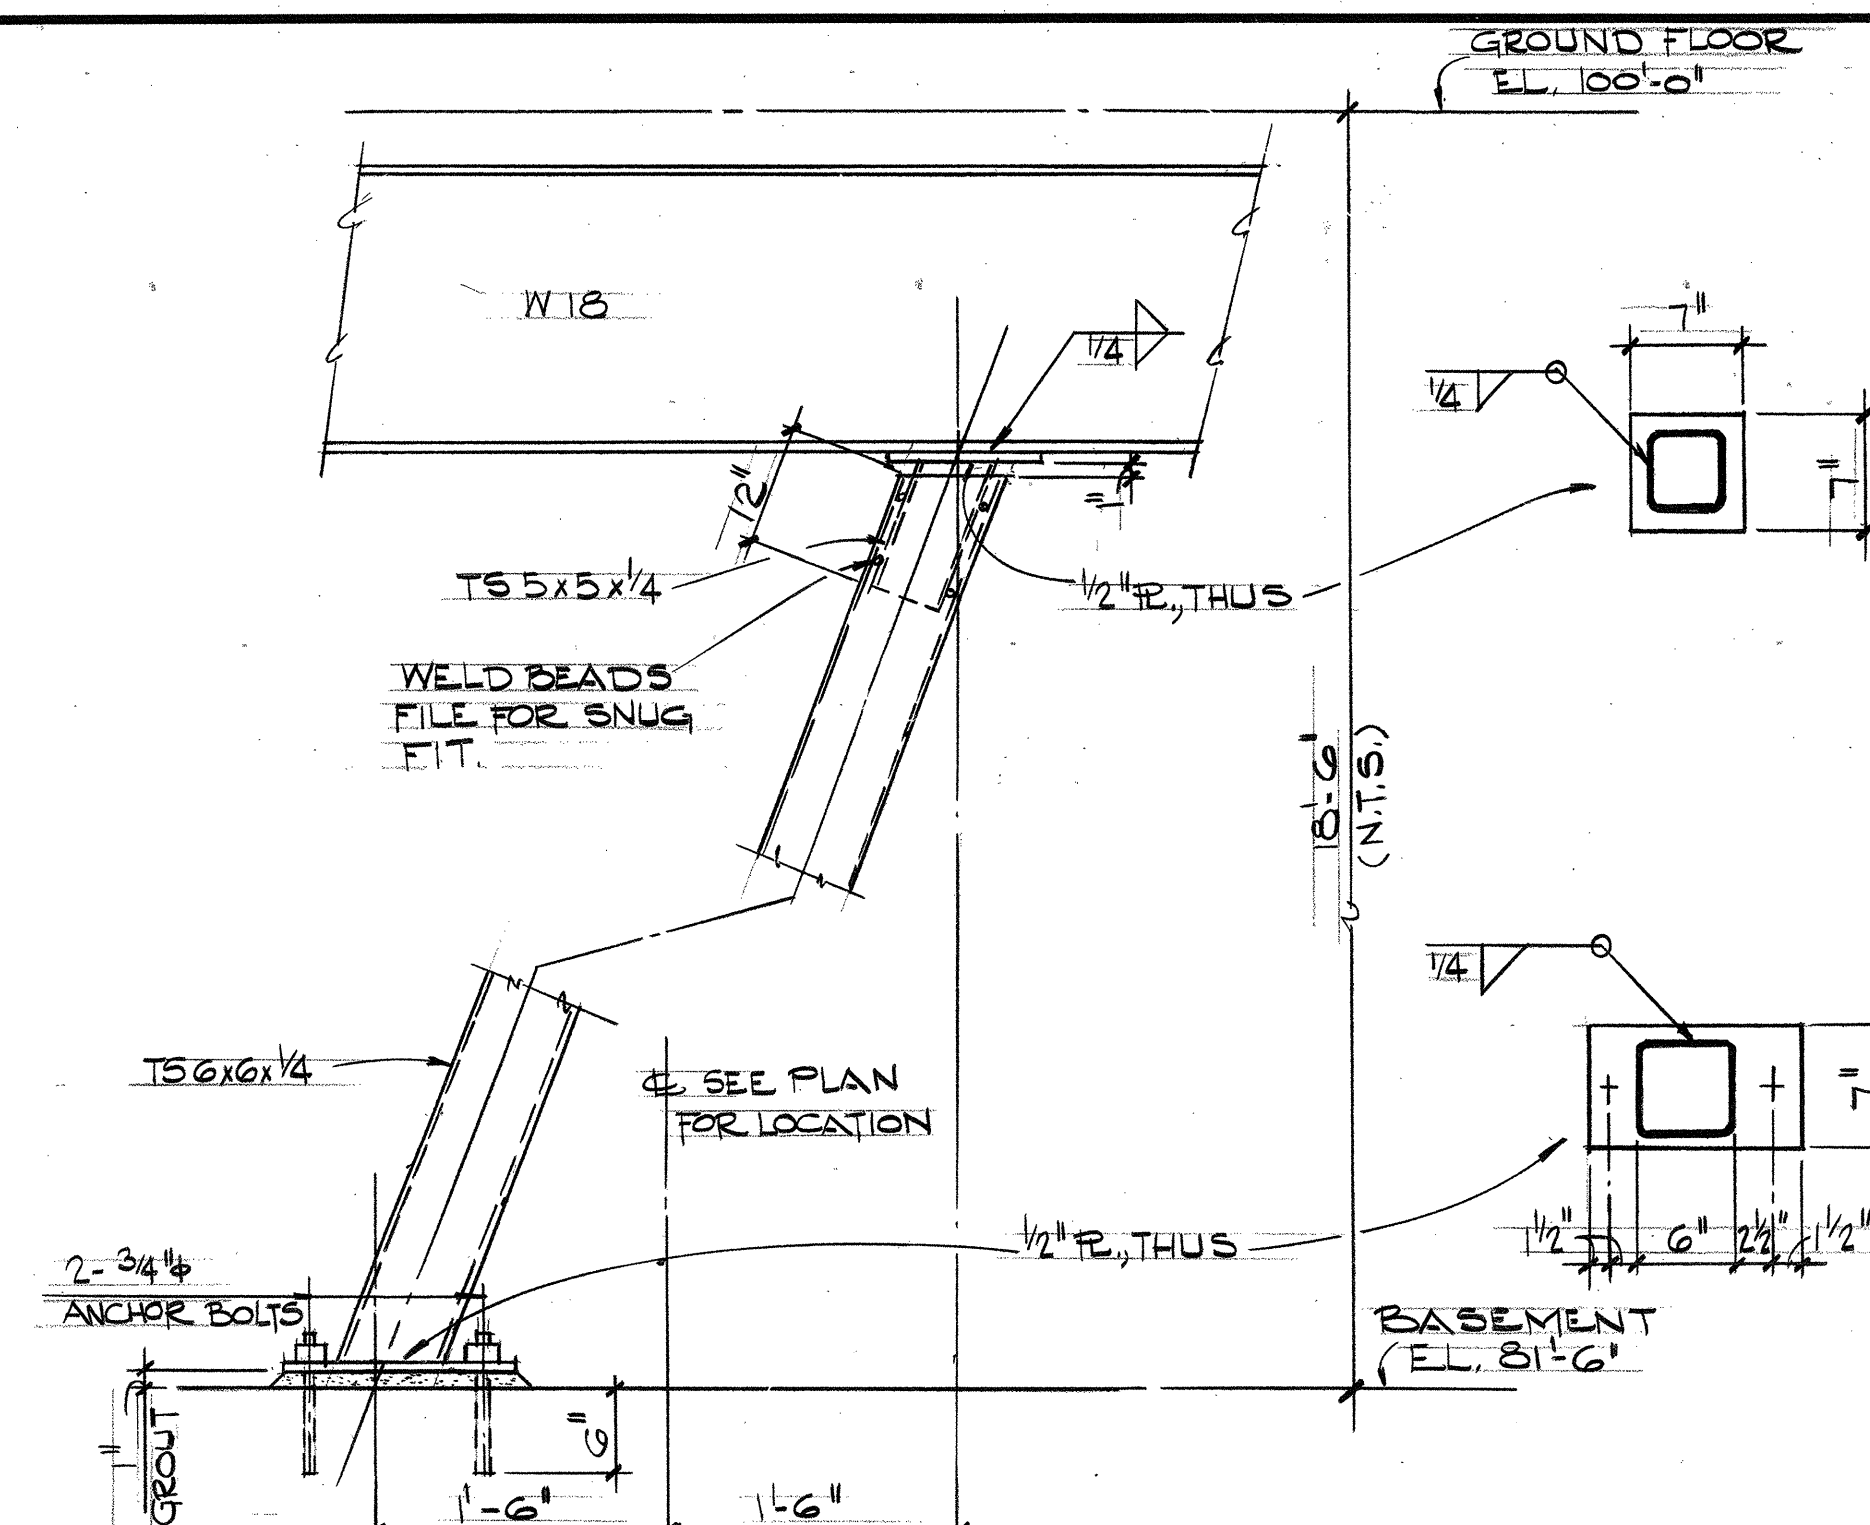

DETAIL 2  
1/2" = 1'-0"

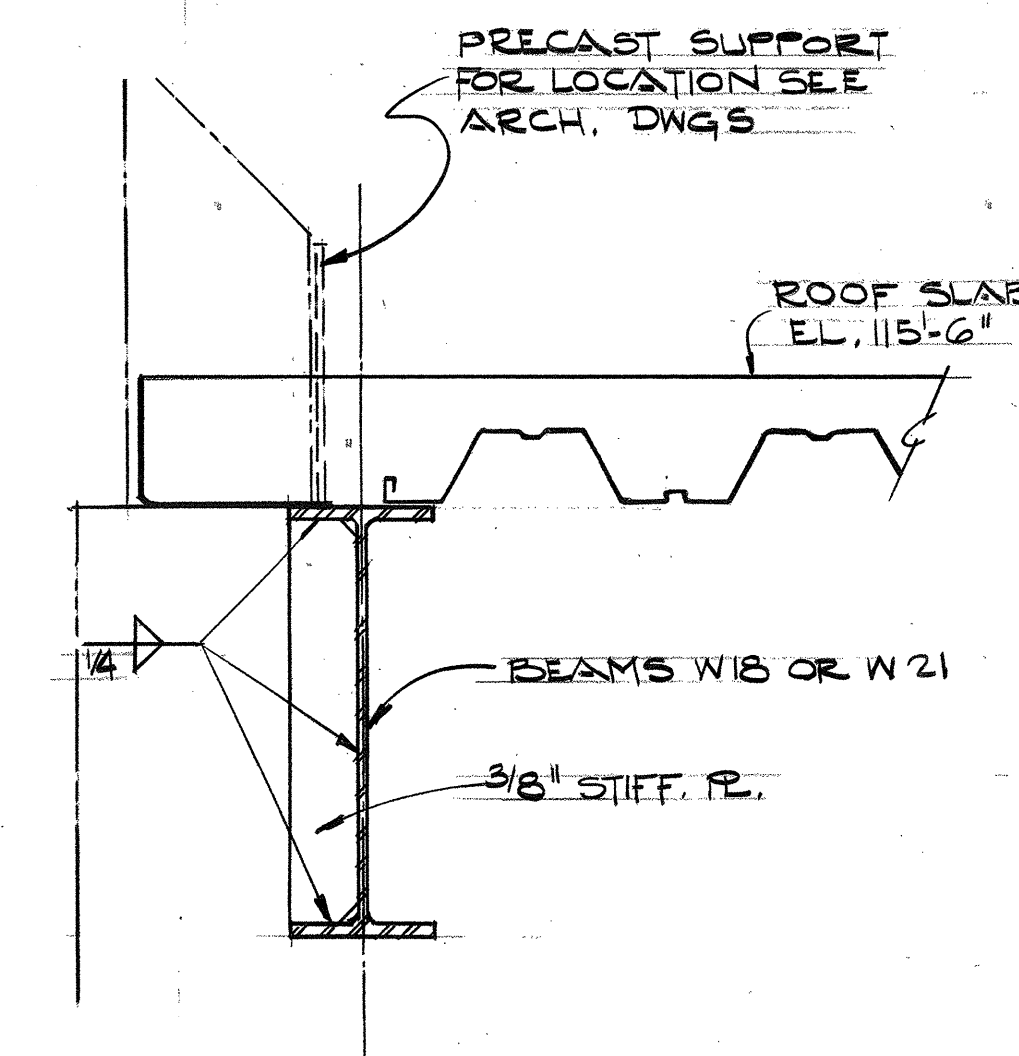

SECTION A  
1/2" = 1'-0"

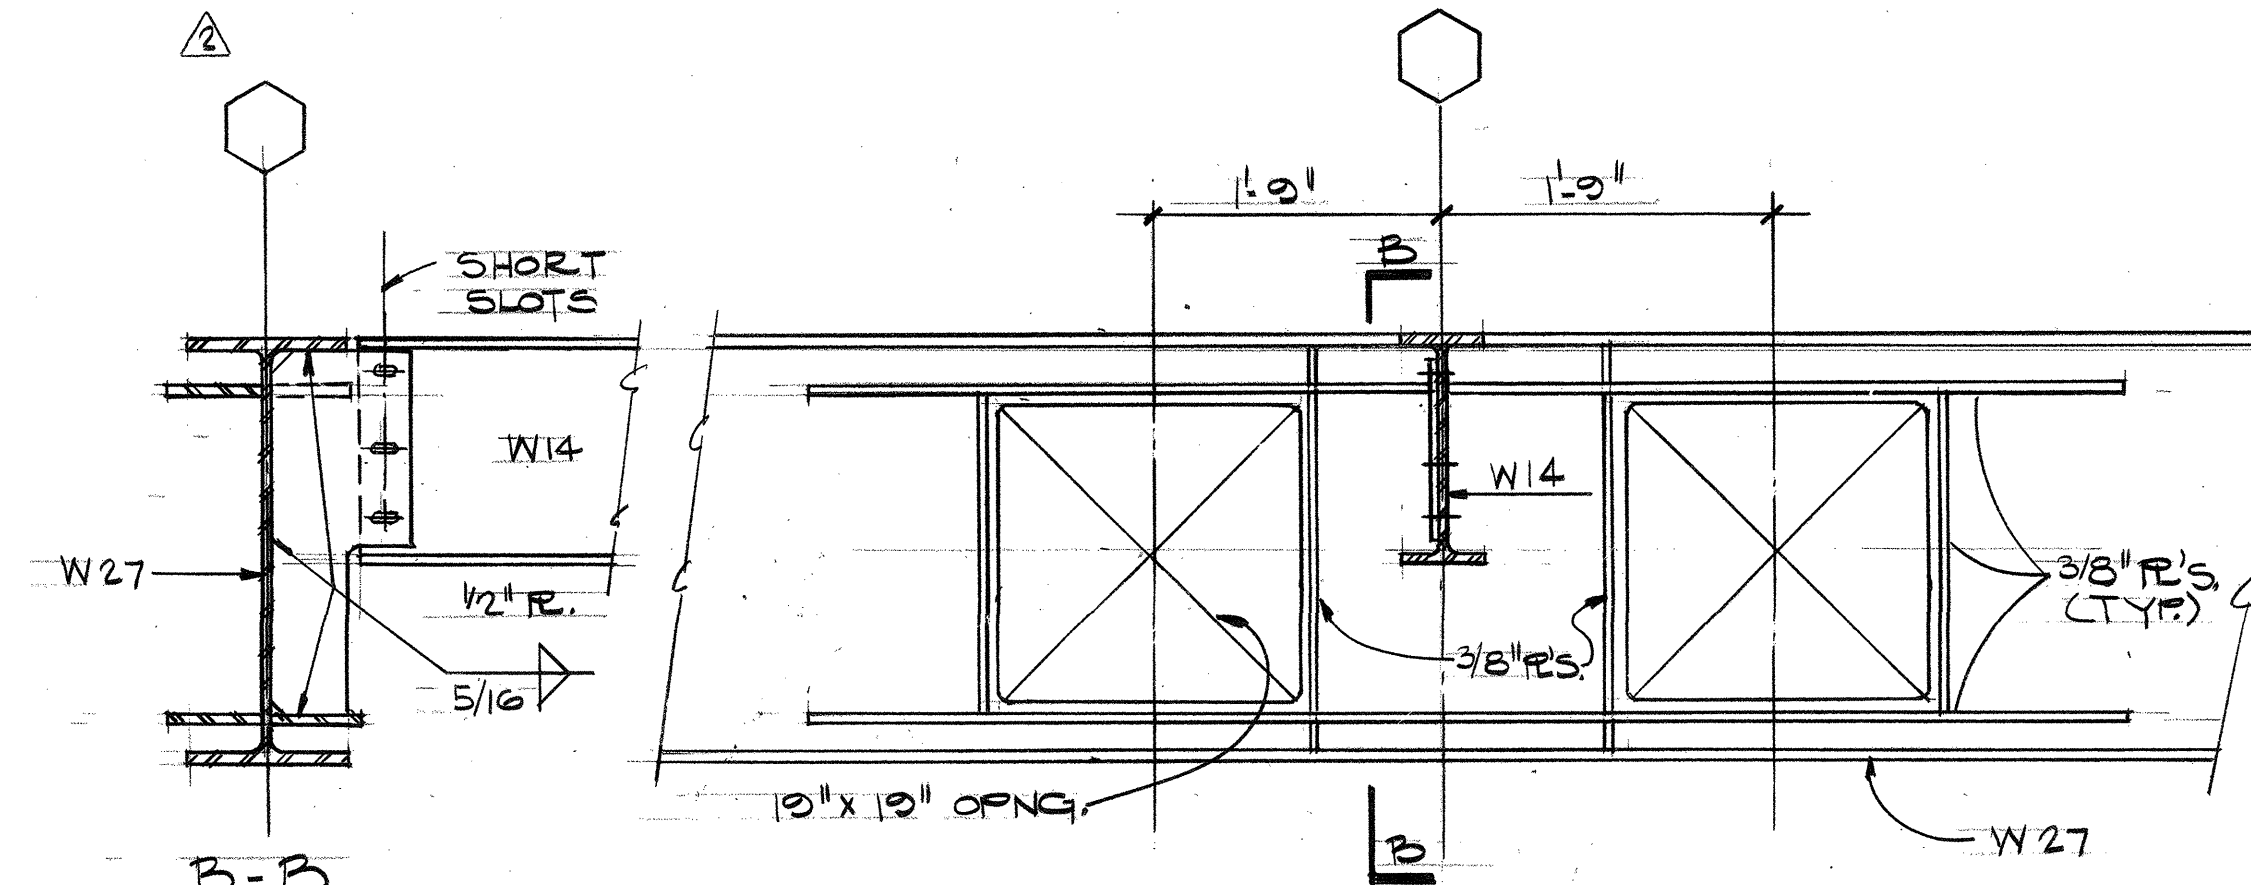

DETAIL 3  
1/2" = 1'-0"

#### NOTES

REFERENCE ELEVATION (26'-5" H.F.)  
TOP OF STEEL (C12, C14) WITH RESPECT TO  
REFERENCE ELEVATION UNLESS NOTED  
THUS: C12, C14  
FOR GENERAL NOTES SEE 50  
FOR TYPICAL STEEL DETAILS SEE 53  
FOR TYPICAL METAL DECK DETAILS SEE 53  
FOR COLUMNS & FRAME GIRDERS SEE 53

## Norwalk Building 43

Norwalk, California

Skidmore, Owings & Merrill  
Architects/Engineers  
One Maritime Plaza  
San Francisco, California

Jaros, Baum & Bolles  
Consulting Engineers  
345 Park Avenue  
New York, New York

Approved for the Owner by

Approved for the Architect by

Drawn by  
D. PALSTAS  
Job Number  
10255-200

Checked by


Date

#### Revisions

| No. | Revisions Indicated thus Δ:                       | Date    |
|-----|---|---------|
| 1   | ISSUED FOR<br>METAL DECK BID.                     | 11-3-81 |
| 2   | ADDENDUM NO. 3<br>ISSUED FOR<br>CONCRETE BID      | 11-8-81 |
| 3   | ISSUED FOR<br>FOUNDATION & PILE<br>PERMIT         | 12-8-81 |
| 4   | ADDENDUM NO. 16<br>ISSUED FOR MILL<br>ORDER ONLY. | 1-15-82 |
| 5   | ADDENDUM NO. 17<br>ISSUED FOR BUILDING PERMIT     | 1-29-82 |
| 6   | ADDENDUM NO. 26                                   | 2-24-82 |
| 7   | ISSUED FOR DETAILING<br>ADDENDUM NO. 28           | 3-9-82  |
| 8   | ADDENDUM NO. 37<br>ISSUED FOR PLAN CHECK          | 4-8-82  |
| 9   | ADDENDUM NO. 46                                   | 8-5-82  |

SE 11/17

#### KEY PLAN

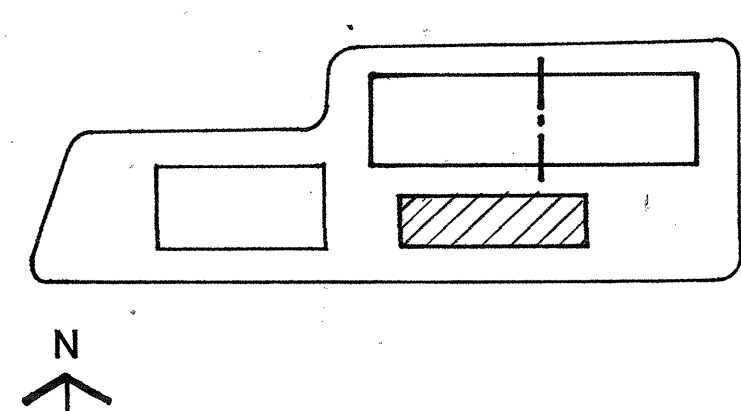

## Cafeteria Penthouse Roof & Misc. Framing

Scale: 1/8" = 1' - 0"

S 104