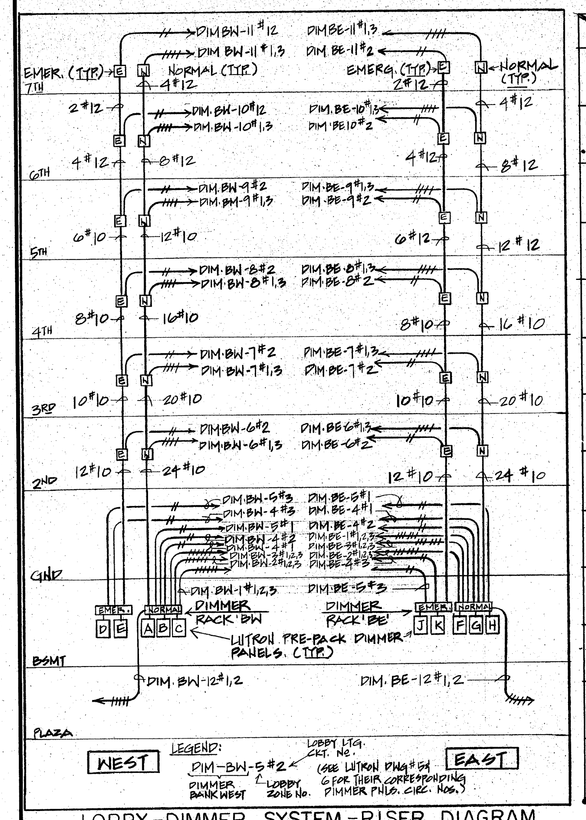

LOBBY-DIMMER SYSTEM-RISER DIAGRAM

NTS

LIGHTING PANEL SCHEDULES 277/480V-3Ø-4W

PANEL DESIGN	MAIN C/B / MAIN BUS	T/F MAIN SW/FU	SPACE FOR POLES	CIRCUIT BREAKERS 20A-1P #12 ACTIVE	20A-1P #12 SPARE	20A-2P #12 ACTIVE	20A-2P #12 SPARE	20A-3P #12 ACTIVE	20A-3P #12 SPARE	30A-3P #10 ACTIVE	30A-3P #10 SPARE	ACTIVE	SPARE	ACTIVE	SPARE	ACTIVE	SPARE	REMARKS
ELP-GW	100AT / 225AF	—	30	14	13					1	0							CKT #26 FOR FEED TO 15 KVA T/F FOR ELP-GW.
				CKT # 1-1						CKT # 26,28, 30								
ELP-GE	100AT / 225AF	—	30	8	10					1	0							CKT #26 FOR FEED TO 15 KVA T/F FOR ELP-GE.
				CKT # 1-8						CKT # 26,28, 30								

VOID

SCHEDULE OF INTERIOR LIGHTING CONTROL RELAYS

RELAY DESIGN.	ASSOC. PANEL	POLES ACT.	POLES SP.	TYPE	NIGHT SETBACK	CLEANING LIGHTS	LOAD SHED SEE NOTE*	CIRCUITS CTLD.
LCR-BNW-A	LP-BNW	4	4	ZENITH #MAG-8.0	●	●		LP-BNW* 1,2,8,12
LCR-BNW-B	LP-BNW	6	6		●		●	LP-BNW* 3,4
LCR-BSW-A	LP-BSW	6	6		●	●		LP-BSW* 5,6
LCR-BSW-B	LP-BSW	2	6		●		●	LP-BSW* 3,4
LCR-BNE-A	LP-BNE	7	5		●	●		LP-BNE* 1,2,5,6,7,8,12
LCR-BNE-B	LP-BNE	4	4		●		●	LP-BNE* 3,4,10,11
LCR-BSE-A	LP-BSE	6	6		●	●		LP-BSE* 1,2,5,6,8,12
LCR-BSE-B	LP-BSE	5	5		●		●	LP-BSE* 3,4,10
LCR-GN-A	LP-GN	6	3		●	●		LP-GN* 1,5,6,10,12
LCR-GN-B	LP-GN	5	3		●		●	LP-GN* 3,7,8,11,14
LCR-GS-A	LP-GS	5	3		●	●		LP-GS* 1,2,5,6,12
LCR-GS-B	LP-GS	8	4		●		●	LP-GS* 3,4,7,8,10,11,13,14
LCR-2NW-A	LP-2NW	7	5		●	●		LP-2NW* 1,4,5,6,8,9,12
LCR-2NW-B	LP-2NW	5	3		●		●	LP-2NW* 2,3,10,11,14
LCR-2SW-A	LP-2SW	7	1		●	●		LP-2SW* 1,4,6,8,9,11,12
LCR-2SW-B	LP-2SW	6	2		●		●	LP-2SW* 2,3,10,9,11,12
LCR-2NE-A	LP-2NE	7	5		●	●		LP-2NE* 1,2,5,6,9,10,12
LCR-2NE-B	LP-2NE	6	2		●		●	LP-2NE* 3,4,7,8,11,14
LCR-2SE-A	LP-2SE	8	0		●	●		LP-2SE* 1,2,5,6,7,8,10,11
LCR-2SE-B	LP-2SE	6	2		●		●	LP-2SE* 3,4,8,9,10,13
LCR-3NW-A	LP-3NW	7	1		●	●		LP-3NW* 1,2,5,6,8,9,12
LCR-3NW-B	LP-3NW	5	3		●		●	LP-3NW* 3,4,10,11,14
LCR-3SW-A	LP-3SW	8	0		●	●		LP-3SW* 1,2,5,6,9,10,11,14
LCR-3SW-B	LP-3SW	6	2		●		●	LP-3SW* 3,4,7,9,11,12
LCR-3NE-A	LP-3NE	7	1		●	●		LP-3NE* 1,2,5,6,9,10,12
LCR-3NE-B	LP-3NE	5	3		●		●	LP-3NE* 3,4,8,11,14
LCR-3SE-A	LP-3SE	6	2		●	●		LP-3SE* 1,2,5,6,8,10
LCR-3SE-B	LP-3SE	5	3		●		●	LP-3SE* 3,4,13,8,10
LCR-4NW-A	LP-4NW	7	1		●	●		LP-4NW* 1,2,5,6,8,9,12
LCR-4NW-B	LP-4NW	8	3		●		●	LP-4NW* 3,4,10,11,14
LCR-4SW-A	LP-4SW	8	0		●	●		LP-4SW* 1,2,5,6,9,10,11,14
LCR-4SW-B	LP-4SW	6	2		●		●	LP-4SW* 3,4,7,9,11,12
LCR-4NE-A	LP-4NE	7	1		●	●		LP-4NE* 1,2,5,6,9,10,12
LCR-4NE-B	LP-4NE	5	3		●		●	LP-4NE* 3,4,8,11,14
LCR-4SE-A	LP-4SE	6	2		●	●		LP-4SE* 1,2,5,6,8,10
LCR-4SE-B	LP-4SE	5	3		●		●	LP-4SE* 3,4,13,8,10
LCR-5NW-A	LP-5NW	7	1		●	●		LP-5NW* 1,2,5,6,8,9,12
LCR-5NW-B	LP-5NW	5	3		●		●	LP-5NW* 3,4,10,11,14
LCR-5SW-A	LP-5SW	8	0		●	●		LP-5SW* 1,2,5,6,9,10,11,14
LCR-5SW-B	LP-5SW	6	2		●		●	LP-5SW* 3,4,7,9,11,12
LCR-5NE-A	LP-5NE	7	1		●	●		LP-5NE* 1,2,5,6,9,10,12
LCR-5NE-B	LP-5NE	5	3		●		●	LP-5NE* 3,4,8,11,14
LCR-5SE-A	LP-5SE	6	2		●	●		LP-5SE* 1,2,5,6,8,10
LCR-5SE-B	LP-5SE	5	3		●		●	LP-5SE* 3,4,13,8,10
LCR-6NW-A	LP-6NW	7	1		●	●		LP-6NW* 1,2,5,6,8,9,12
LCR-6NW-B	LP-6NW	5	3		●		●	LP-6NW* 3,4,10,11,14
LCR-6SW-A	LP-6SW	8	0		●	●		LP-6SW* 1,2,5,6,9,10,11,14
LCR-6SW-B	LP-6SW	6	2		●		●	LP-6SW* 3,4,7,9,11,12
LCR-6NE-A	LP-6NE	7	1		●	●		LP-6NE* 1,2,5,6,9,10,12
LCR-6NE-B	LP-6NE	5	3		●		●	LP-6NE* 3,4,8,11,14
LCR-6SE-A	LP-6SE	6	2		●	●		LP-6SE* 1,2,5,6,8,10
LCR-6SE-B	LP-6SE	5	3		●		●	LP-6SE* 3,4,13,8,10
LCR-7NW-A	LP-7NW	7	1		●	●		LP-7NW* 1,2,5,6,8,9,12
LCR-7NW-B	LP-7NW	5	3		●		●	LP-7NW* 3,4,10,11,14
LCR-7SW-A	LP-7SW	8	0		●	●		LP-7SW* 1,2,5,6,9,10,11,14
LCR-7SW-B	LP-7SW	6	2		●		●	LP-7SW* 3,4,7,9,11,12
LCR-7NE-A	LP-7NE	7	1		●	●		LP-7NE* 1,2,5,6,9,10,12
LCR-7NE-B	LP-7NE	5	3		●		●	LP-7NE* 3,4,8,11,14
LCR-7SE-A	LP-7SE	6	2		●	●		LP-7SE* 1,2,5,6,8,10
LCR-7SE-B	LP-7SE	4	4		●		●	LP-7SE* 3,4,8,10

NOTE: ALL LIGHTING CONTACTOR RELAYS ARE FURNISHED W/ 120V-3P AUXILIARY CONTROL SWITCHING RELAYS INSIDE ENCLOSURE (ALL SWITCHED FROM SECURITY LIGHTING CONSOLE IN GRND FL.)

LIGHTING PANEL SCHEDULES 277/480V-3Ø-4W

PANEL DESIGN	MAIN C/B / MAIN BUS	T/F MAIN C/B	SPACE FOR POLES	CIRCUIT BREAKERS 20A-1P #12 ACTIVE	20A-1P #12 SPARE	20A-2P #12 ACTIVE	20A-2P #12 SPARE	20A-3P #12 ACTIVE	20A-3P #12 SPARE	30A-3P #10 ACTIVE	30A-3P #10 SPARE	20A-3P #10 ACTIVE	20A-3P #10 SPARE	60A-3P #4 ACTIVE	60A-3P #4 SPARE	REMARKS
LP-BNW	NONE / 225A	—	30	8	19									1	0	PROVIDE CKT #28 FOR 45 KVA TRANSFORMER FEED FOR DISTR. PANEL SPACE
				CKT # 1-6,8,10										CKT # 26,28, 30		
LP-BSW	NONE / 225A	—	30	5	13			1	0					1	0	
				CKT # 1-7,9, 11				CKT # 8						CKT # 26		
LP-BNE	NONE / 225A	—	30	12	18									1	0	
				CKT # 1-12										CKT # 26,28, 30		
LP-BSE	NONE / 225A	—	30	10	17									1	0	
				CKT # 1-8,10-15										CKT # 26,28, 30		
LP-GW	NONE / 225A	—	30	3	21									1	0	CKT # 2-3P-10A, C/B
				CKT # 1-2,4,6										CKT # 26,28, 30		
LP-GE	NONE / 225A	—	30	3	3			4	0			3	0	1	0	
				CKT # 1,2,22				CKTS # 3,5,7,9, 6,8,10,12,14,11, 13,15				CKTS # 16,18,20, 17,19,21,23,25, 27		CKT # 26,28, 30		
LP-GN	NONE / 225A	—	30	12	15									1	0	
				CKT # 1-8,10,12,14, 11										CKT # 26,28, 30		
LP-GS	NONE / 225A	—	30	19	12									1	0	
				CKT # 1-15										CKT # 26,28, 30		
LP-2NW	NONE / 225A	—	30	13	12									1	0	
				CKT # 1-12,14										CKT # 26,28, 30		
LP-2SW	NONE / 225A	—	30	12	10							1	0	1	0	
				CKT # 1 -12								CKT # 25, 27, 29		CKT # 26, 28, 30		
LP-2NE	NONE / 225A	—	30	13	13									1	0	CKT # 29-1P-40A C/B
				CKT # 1-12,14										CKT # 26,28, 30		
LP-2SE	NONE / 225	—	30	12	16									1	0	
				CKT # 1-11,13										CKT # 26,28, 30		
LP-3NW	NONE / 225A	—	30	13	11			1	0					1	0	
				CKT # 1-12,14				CKT # 20, 22, 24						CKT # 26,28, 30		
LP-3SW	NONE / 225A	—	30	13	11							1	0	1	0	
				CKT # 1-12, 14								CKT # 25, 27, 29		CKT # 26,28, 30		
LP-3NE	NONE / 225A	—	30	13	14									1	0	
				CKT # 1-12,14										CKT # 26,28, 30		
LP-3SE	NONE / 225A	—	30	9	18									1	0	
				CKT # 1-6,8, 10,12										CKT # 26,28, 30		
LP-4NW	NONE / 225A	—	30	14	13									1	0	
				CKT # 1-12, 14										CKT # 26,28, 30		
LP-4SW	NONE / 225A	—	30	13								1	0	1	0	
				CKT # 1 - 14								CKT # 25, 27, 29		CKT # 26, 28, 30		
LP-4NE	NONE / 225A	—	30	13	14									1	0	
				CKT # 1-12,14										CKT # 26,28, 30		
LP-4SE	NONE / 225A	—	30	9	18									1	0	
				CKT # 1-6,8, 10,13										CKT # 26,28, 30		
LP-5NW	NONE / 225A	—	30	13	11			1	0					1	0	
				CKT # 1-12,14				CKT # 20, 22, 24						CKT # 26,28, 30		
LP-5SW	NONE / 225A	—	30	13	11							1	0	1	0	
				CKT # 1-12, 14								CKT # 25, 27, 29		CKT # 26, 28, 30		
LP-5NE	NONE / 225A	—	30	13	14									1	0	
				CKT # 1-12,14										CKT # 26,28, 30		
LP-5SE	NONE / 225A	—	30	9	18									1	0	
				CKT # 1-6,8, 10,13										CKT # 26,28, 30		
LP-6NW	NONE / 225A	—	30	14	13									1	0	
				CKT # 1-12,14,20										CKT # 26,28, 30		
LP-6SW	NONE / 225A	—	30	13	11							1	0	1	0	
				CKT # 1-12, 14								CKT # 25, 27, 29		CKT # 26, 28, 30		
LP-6NE	NONE / 225A	—	30	13	14									1	0	
				CKT # 1-12,14										CKT # 26,28, 30		
LP-6SE	NONE /	—	30	9	18									1	0	
				CKT # 1-6,8, 10,13										CKT # 26,28, 30		
LP-7NW	NONE / 225A	—	30	13	10	1	0	0	1					1	0	
				CKT # 1-12,14		CKT # 25, 27, 29		CKT # 13, 15, 17						CKT # 26,28, 30		
LP-7SW	NONE / 225A	—	30	3	11			0	1					1	0	
				CKT # 1- 12,				CKT # 13, 15, 17						CKT # 26,28, 30		
LP-7NE	NONE / 225A	—	30	13	8			0	2					1	0	
				CKT # 1-12,14				CKT # 13, 15, 16, 18, 17, 20						CKT # 26,28, 30		
LP-7SE	NONE / 225A	—	30	8	16			0	1					1	0	
				CKT # 1-6,8, 10				CKT # 13, 15 17						CKT # 26,28, 30		
LP-OL 1&2	NONE / 225A (2 SECTIONS)	—	24	16	6							1				PROVIDE SPLIT BUS SECTION + BE SCNTLD BY AGCO SOLUTIONS SEE NOTES on DWG E-1
				CKT # 1-7,9,11, 13-18,20								CKT # 10, 12 VIA 5 KVA T/F				

VOID

Norwalk
Building 43

Norwalk, California

Skidmore, Owings & Merrill
Architects/Engineers
One Maritime Plaza
San Francisco, California

Jaros, Baum & Bolles
Consulting Engineers
345 Park Avenue
New York, New York

Approved for the Owner by

Approved for the Architect by

Drawn by | Job Number

Checked by | Date

Revisions

No.	Revisions indicated thus △:	Date
	ISSUED FOR BID	12-15-81
1	ADDENDUM NO 20	2-4-82
2	ADDENDUM NO 37 ISSUED FOR BUILDING PERMIT	4-30-82
3	ADDENDUM #65	8-5-82
4	ADDENDUM #78	10-1-82
5	ADDENDUM #90	11-10-82
6	ADDENDUM #99	1-18-83
7	ADDENDUM #100	1-19-83
8	ADDENDUM #103	2-4-83
9	ADDENDUM #132	6-21-83
	AS BUILT 1-6-84	

KW AS BUILT UPDATE — TJ | WM | LD

NO. | DATE | REVISIONS | DRN | CHK | PROJ ENG

BECHTEL LOS ANGELES JOB NO. 848-0080

SE 8748

KEY PLAN

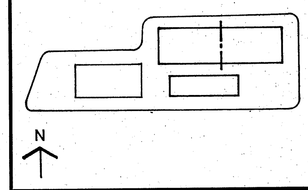

LIGHTING PANEL SCHEDULE

E·28

2-15-84