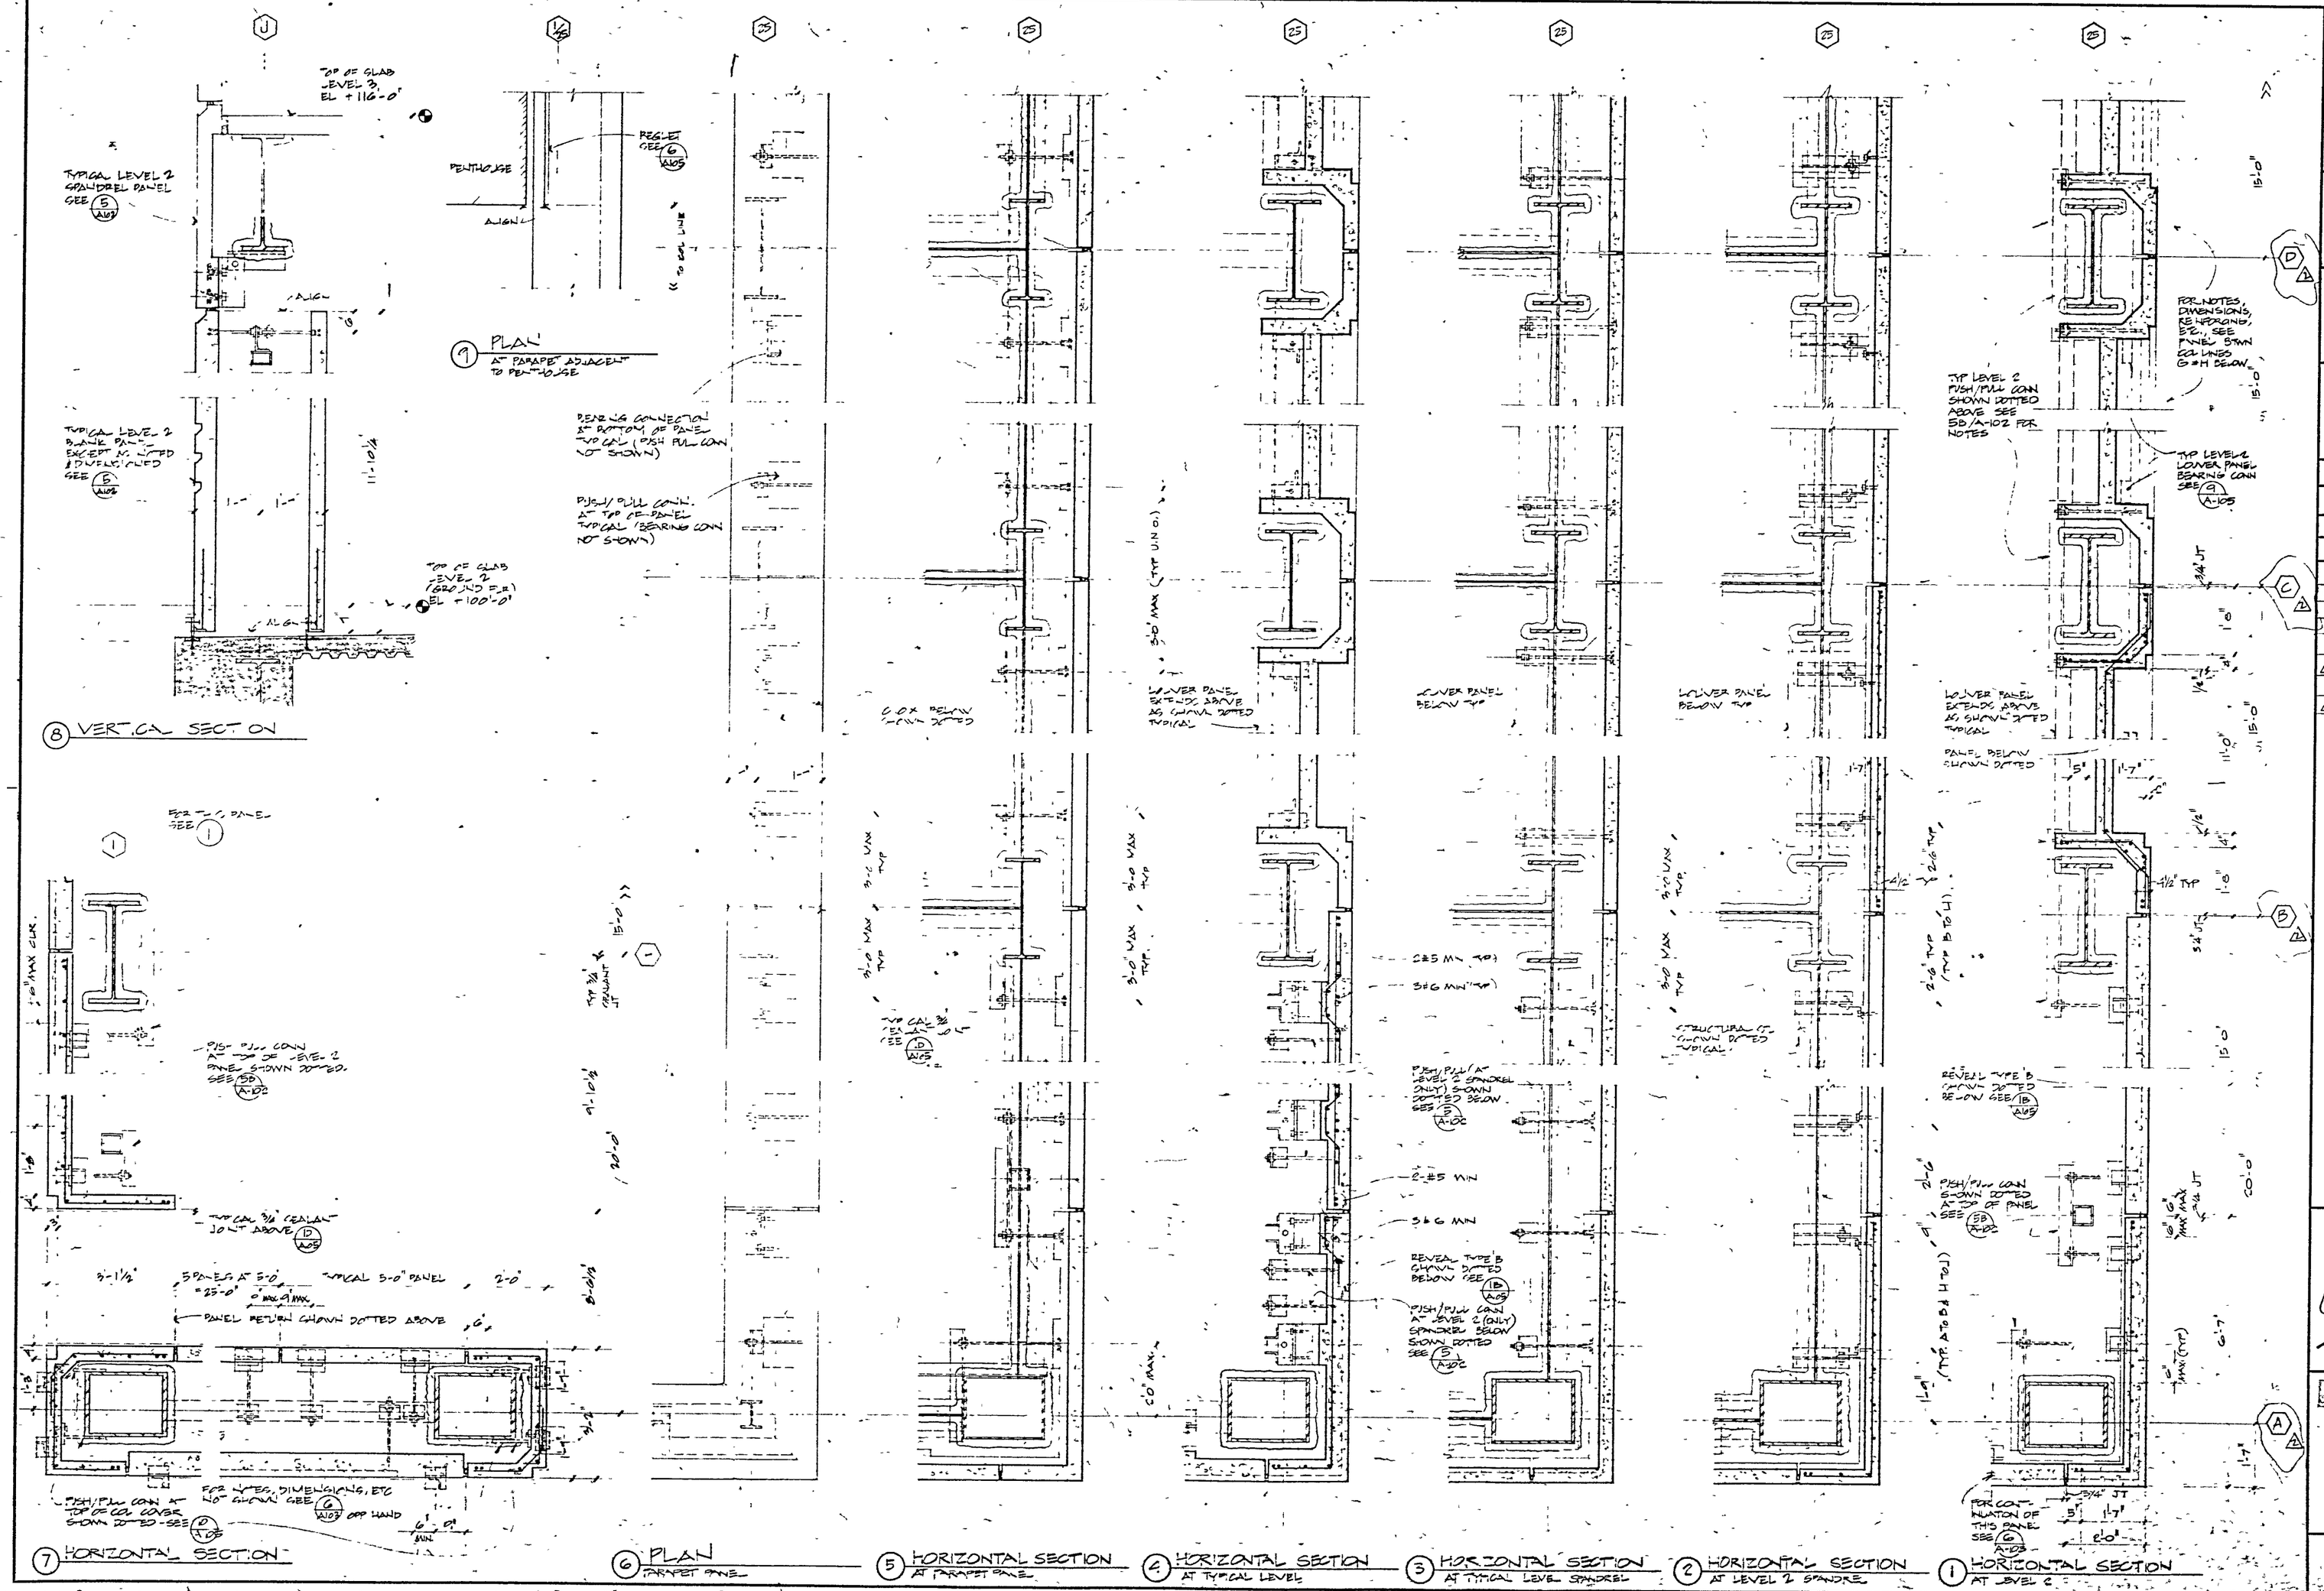

Norwalk
Building 43

Norwalk, California

Skidmore, Owings & Merrill
Architects/Engineers
One Maritime Plaza
San Francisco, California

Jaros, Baum & Bolles
Consulting Engineers
345 Park Avenue
New York, New York

Approved for the Owner by

Approved as to Architecture by C-1846

Drawn by A. GRANT | Job Number 12293-200

Checked by R. [illegible] | Date

Revisions

No.	Revisions Indicated Back △	Date
	ISSUED FOR PRECAST DID 10 15 B1	
	ADDENDUM No. 3	10-28-81
	ISSUED FOR PLAN CHECK	1-29-82
3	△ ADDENDUM No 29	5-13-82
	ADDENDUM NO 37 - ISSUED FOR BUILDING PERMIT	6-30-82
4	△ ADDENDUM NO 40	6-21-82

KEY PLAN

N M H SIMPSON JUN 21 1982

PRECAST DETAILS

SCALE: 3/4" = 1'-0"

A-104