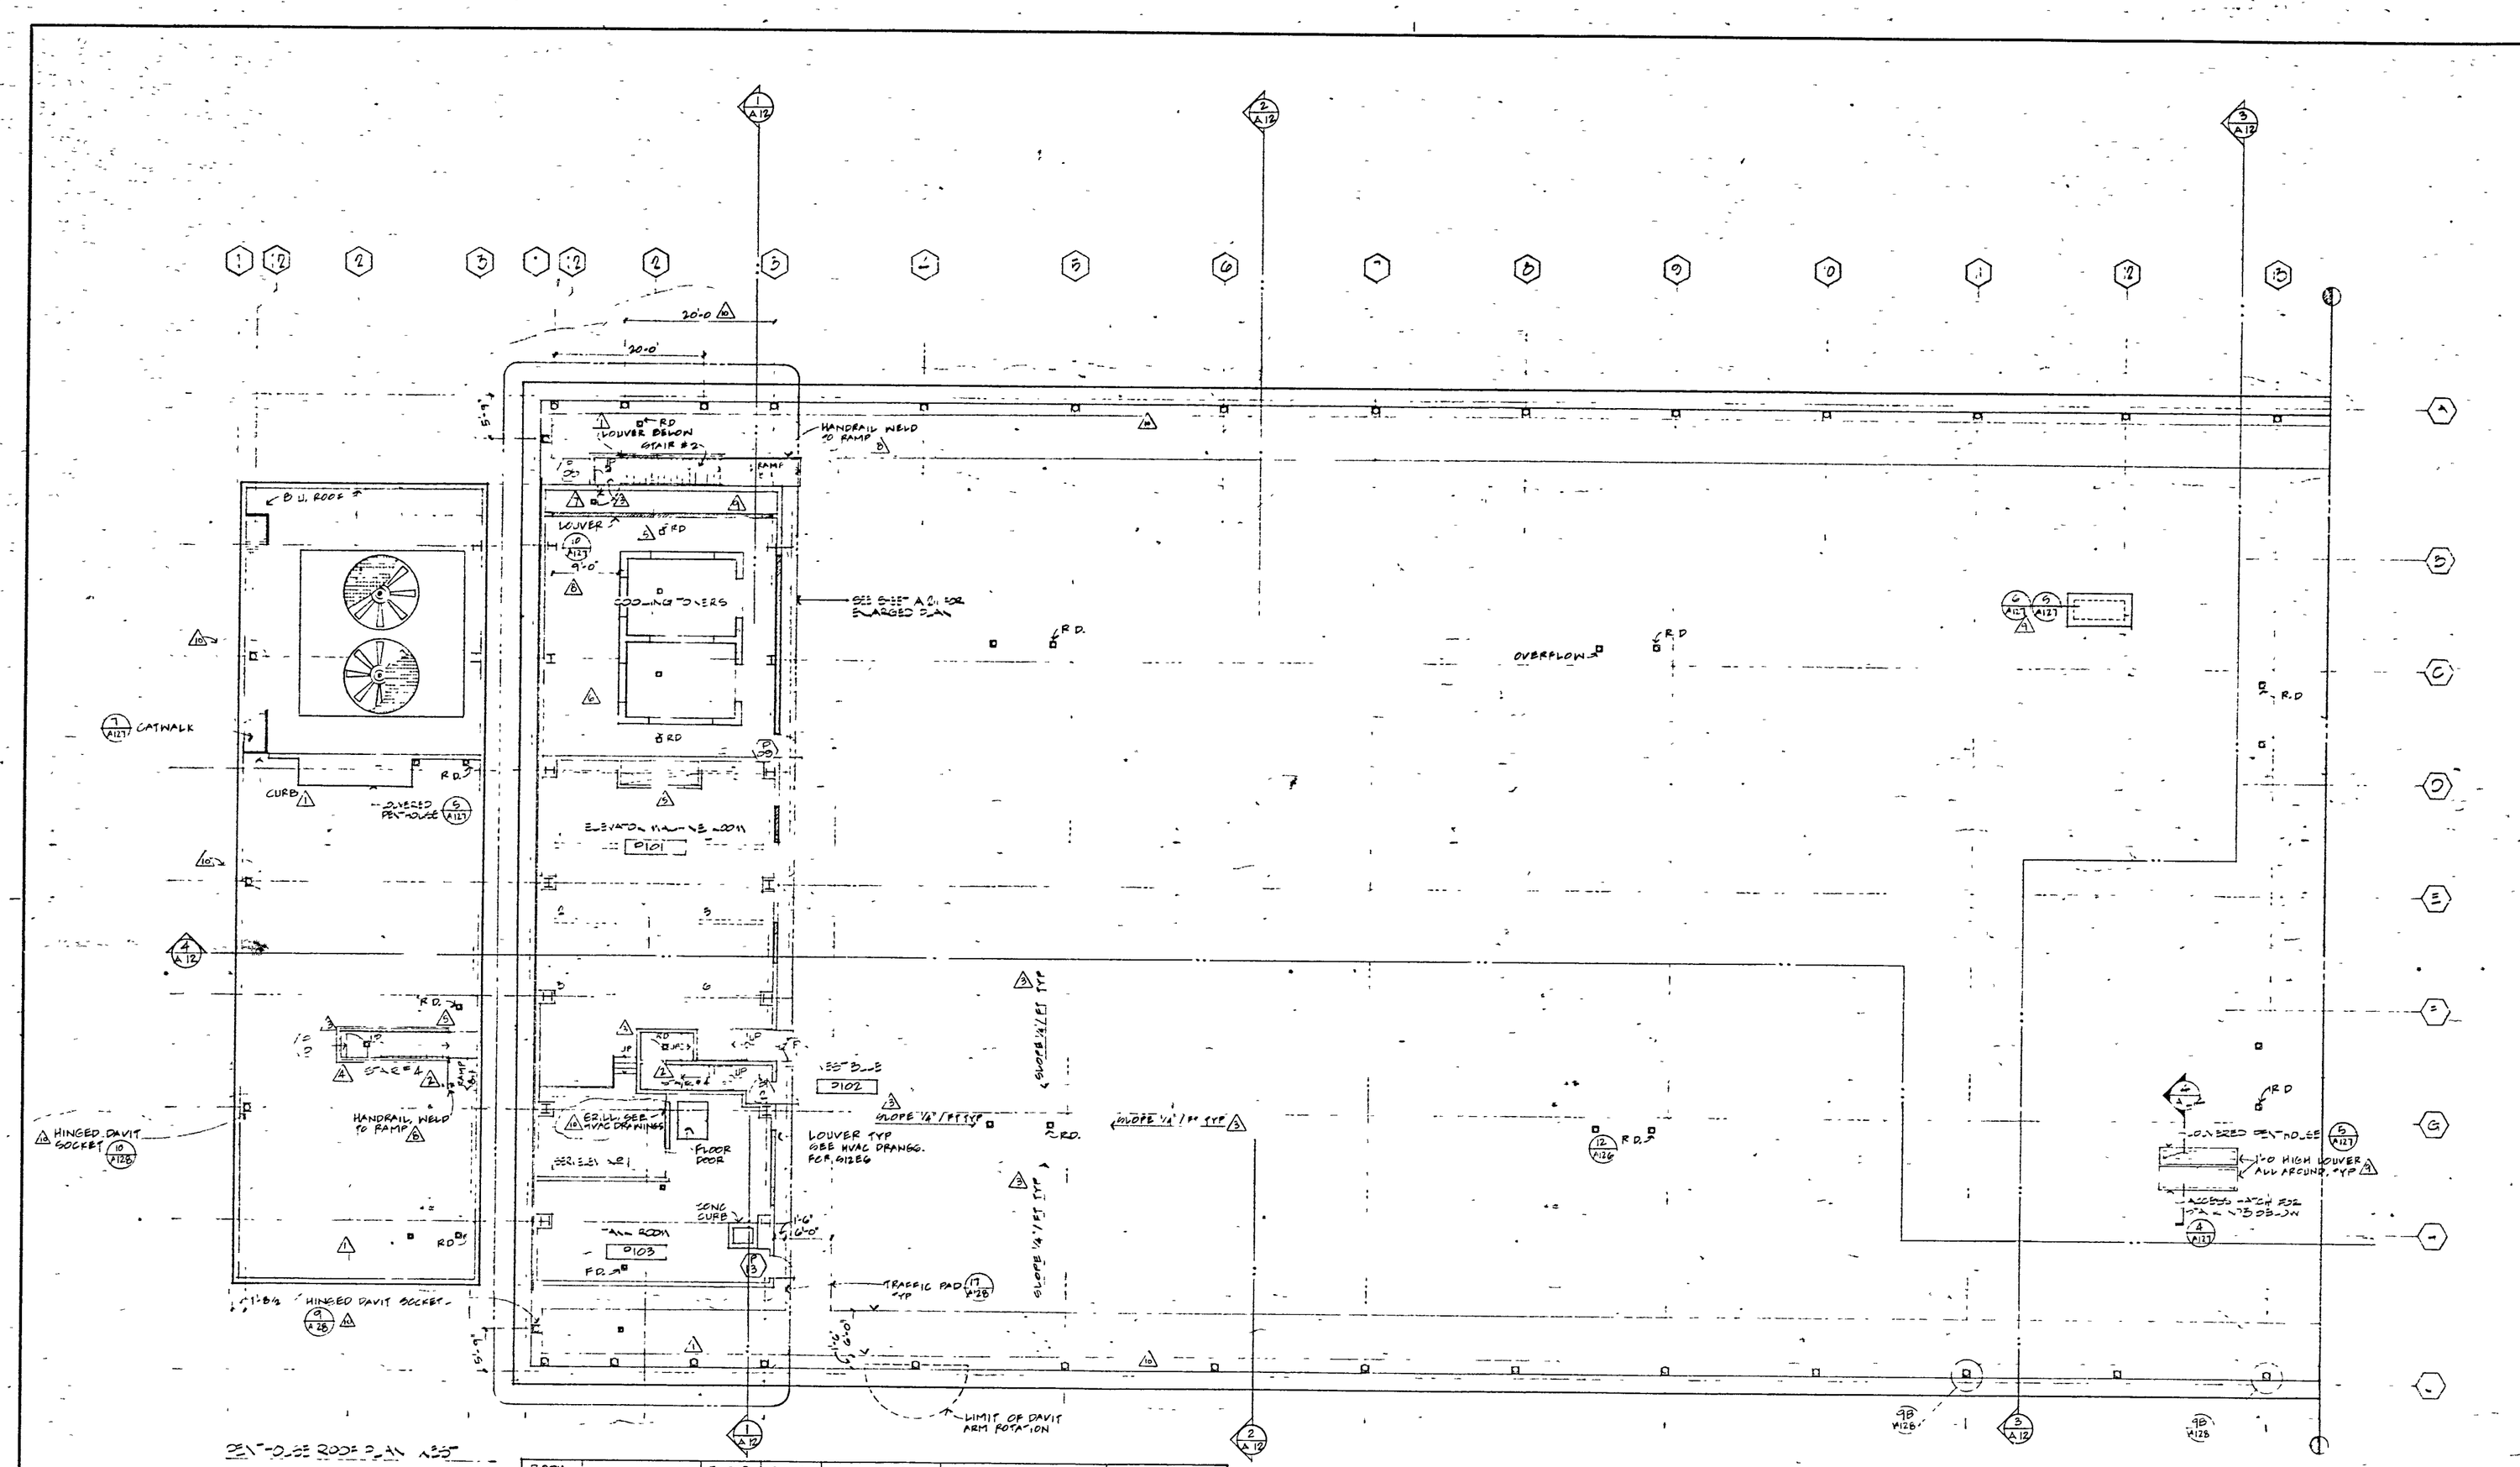

PENTHOUSE ROOF PLAN 1/8"

ROOM NO	NAME	FLOOR MAT'L	BASE MAT'L	WALLS MAT'L	WALLS FIN	CEILING MAT'L	CEILING FIN	CEILING HT	REMARKS
0101	ELEV MACH ROOM	CONC	CB	CB	GLOSS	EXP	—	—	
0102	ELEV SHAFT	CONC	CB	GB	GLOSS	EXP	—	—	
0103	TANK ROOM	EL.	EL.	GB	GLOSS	EXP	—	—	
	COOLING TOWERS	X	X	SEE NOTE 1	X	—	—	—	SEE NOTE 3
	STAIR #2	CONC	X	CB	SEE NOTE 1	X	—	—	SEE NOTE 2
	STAIR #6	CONC	X	CB	SEE NOTE 1	X	—	—	SEE NOTE 2

GENERAL NOTES

1. SEE D.U. ELEVATIONS FOR SCREEN AREA ENLARGEMENTS.
2. CONC. TO BE STAINED TO MATCH ENERGYGUARD COATING.
3. COOLING TOWER AREA SCREENING TO BE 8'-0" HIGH SCREENING FOR COOLING TOWER SEE A2.1.

Norwalk
Building 43
Norwalk, California

Skidmore, Owings & Merrill
Architects/Engineers
One Maritime Plaza
San Francisco, California

Jaros, Baum & Bolles
Consulting Engineers
345 Park Avenue
New York, New York

Approved for the Owner by

Approved by: [signature] Date: C-1846

Drawn by: S CHAPMAN Job Number: 10295-200

Checked by: RJ GAGLIARD Date:

Revisions

No.	Revisions indicated thus Δ	Date
	ISSUED FOR PRECAST BID	9.15.81
	ISSUED FOR ELEVATOR & DUMBWAITER BID	10/16/81
	ISSUED FOR METAL DECK BID	11/30
	ISSUED FOR CONCRETE BID	2.8.82
	ISSUED FOR FOUNDATION & P.U.C. PERMIT	
	ISSUED FOR PLAN CHECK	3.29.82
	ISSUED FOR FINISH HARDWARE BID.	19-1-82
	ISSUED FOR HOLLOW METAL DOOR & FRAME BID.	4-7-82
	ISSUED FOR GYPSUM DRYWALL BID	4.14.82
	ISSUED FOR METAL LOUVER BID	3.12.82
1	ADDENDUM NO. 29	5.19.82
2	ADDENDUM NO. 33	6-7-82
3	ISSUED FOR BUILDING PERMIT	6-30-82
4	ADDENDUM NO. 63	6.21.82
5	ADDENDUM NO. 60	7.23.82
6	ADDENDUM NO. 67	8.6.82
7	ADDENDUM NO. 73	9.16.82
8	ADDENDUM NO. 86	10.26.82
9	ADDENDUM NO. 88	10.28.82
10	ADDENDUM NO. 96	12.17.82

RECEIVED DEC 27 '82 U.S. CONSTRUCTION

KEY PLAN

N

ROOF PLAN
WEST

SCALE: 1/8" = 1'-0"

A-10