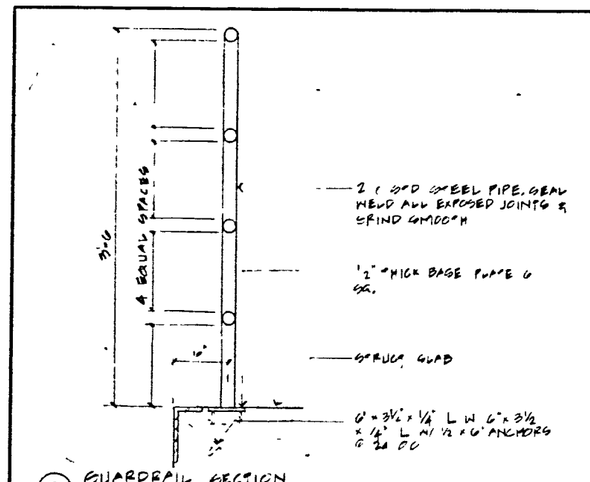

7 GUARDRAIL SECTION
SCALE 1½" = 1'-0"

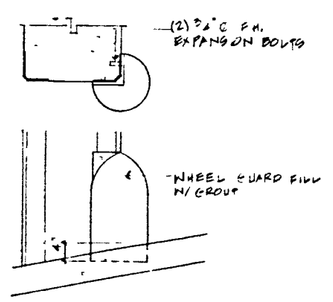

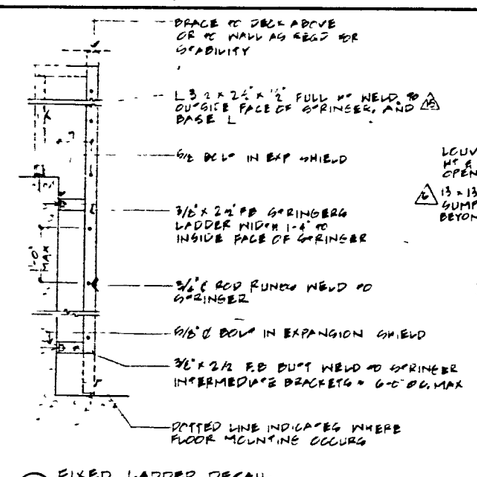

3 FIXED LADDER DETAIL

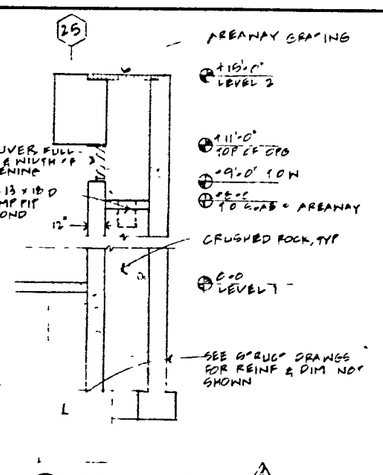

11 AREAWAY SECTION
1/4" = 1'-0"

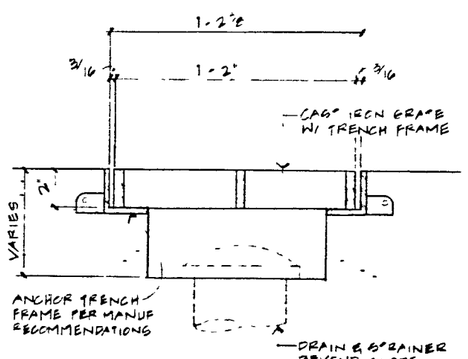

4 DRAIN TRENCH
SCALE 1½" = 1'-0"

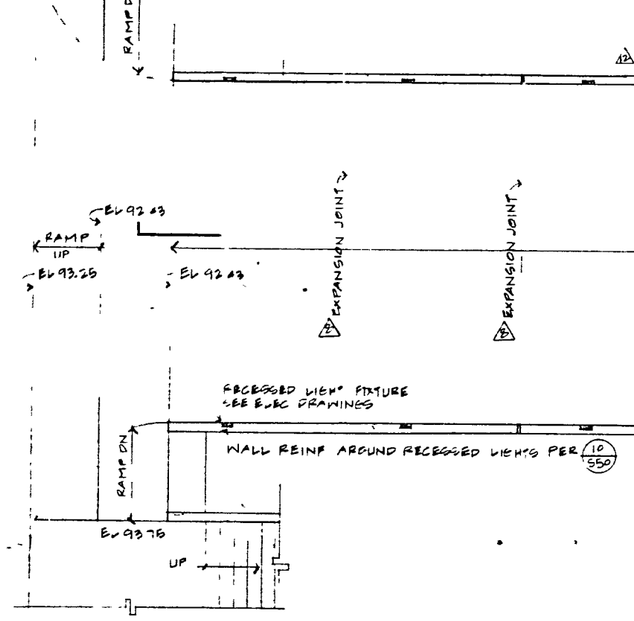

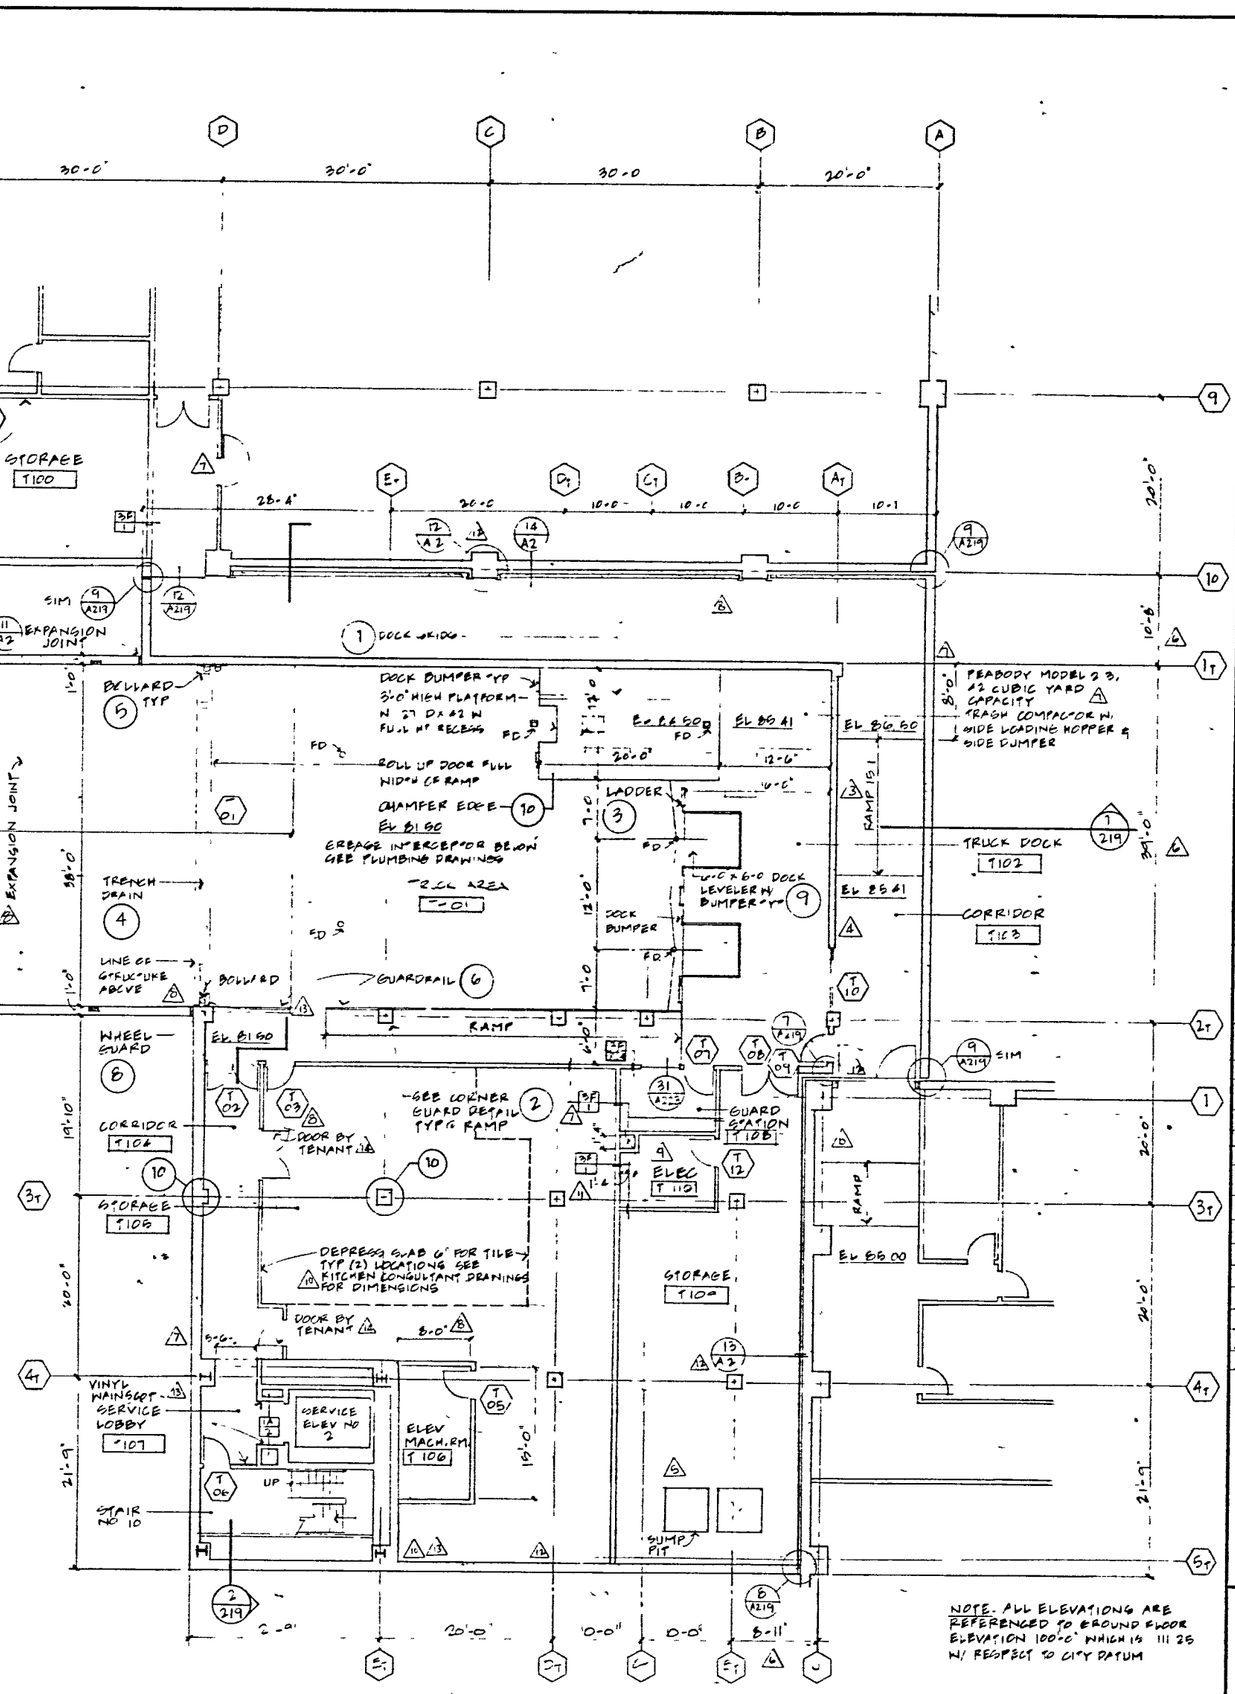

BASEMENT LEVEL / TRUCK DOCK FLOOR PLAN

8 WHEEL GUARD
3/4" = 1'-0"

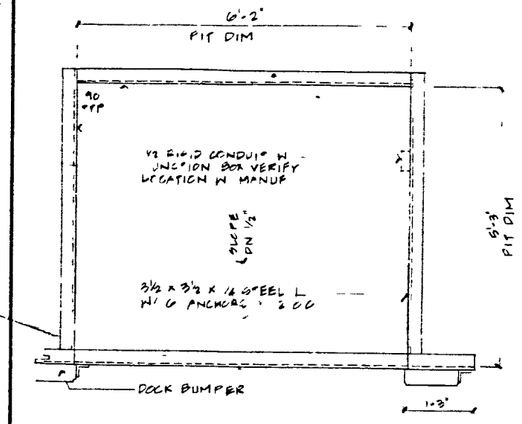

9 DOCK LEVELER PLAN
SCALE 3/4" = 1'-0"

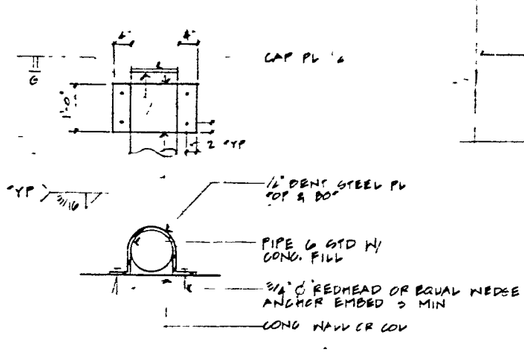

5 BOLLARD GUARD
NO SCALE

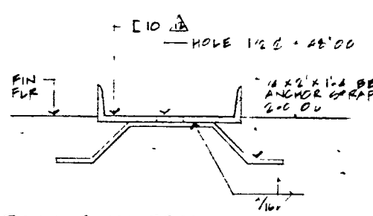

1 DOCK SKID DETAIL
SCALE 3" = 1'-0"

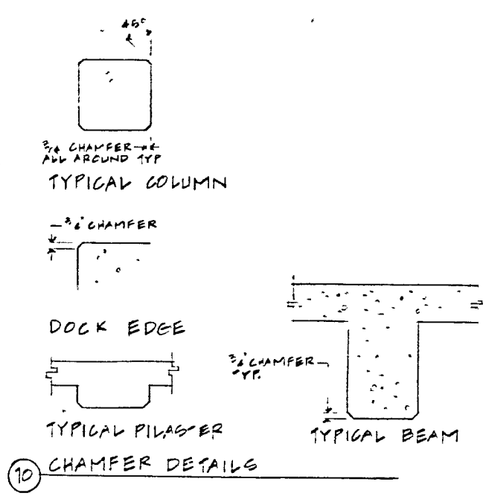

10 CHAMFER DETAILS

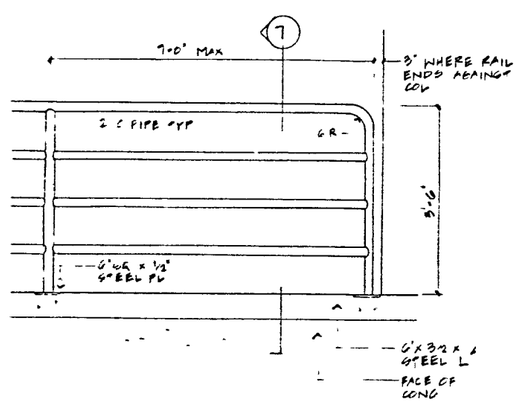

6 GUARDRAIL DETAIL
SCALE 3/4" = 1'-0"

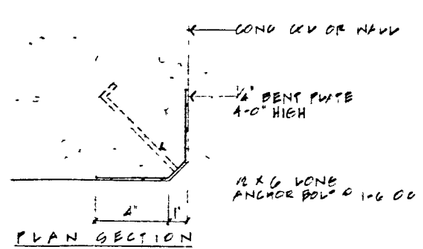

2 CORNER GUARD
3" = 1'-0"

ROOM NO	TITLE	FLOOR MAT	FLOOR BASE	WALLS MAT	WALLS FIN	CEILING MAT	CEILING FIN	CEILING HT	REMARKS
T-100	STORAGE	AT	RB	GB/CONC	EGGE	ACP	—	9'-6"	
T-101	TRUCK AREA	CONC	—	CONC	EGGE	EXP	—	—	
T-102	TRUCK DOCK	CONC	—	CONC	EGGE	EXP	—	—	
T-103	CORR DOR	AT	RB	CONC	EGGE	EXP	—	—	
T-104	CORR DOR	AT	RB	CB	CONC	EGGE	CB	EGGE	VINYL WAINSCOT NORTH WALL ONLY, UNO
T-105	STORAGE	AT	RB	CB	CONC	EGGE	EXP	—	
T-106	ELEV MACH RM	CONC	RB	CB		EGGE	EXP	—	
T-107	SERVICE LOBBY	AT	RB	CB		EGGE	CB	EGGE	9'-0"
T-108	GUARD STATION	AT	RB	CB		EGGE	CB	EGGE	8'-0"
T-109	STORAGE	AT	RB	GB	CONC	EGGE	EXP	—	VINYL WAINSCOT SOUTH WALL ONLY
T-110	ELECTRICAL RM	CONC	RB	CB		EGGE	EXP	—	
		CONC	RB	CB		AT	EXP	—	

REVISIONS

No.	Revisions indicated thus △	Date
	ISSUED FOR METAL DECK BID	11.030
	ISSUED FOR CONCRETE SD ISSUED FOR FOUNDATION & SITE PERMIT	12-8-81
1	ADDENDUM NO. 12	12 18 81
2	ADDENDUM NO 13	12 29 81
	ISSUED FOR PLAN CHECK	1 29 82
	ISSUED FOR CONSTRUCTION BID	3 4 82
3	ADDENDUM NO 29 ISSUED FOR MISC METAL	3 15 82 3-16-82
4	ADDENDUM NO 31	3 23 82
5	ADDENDUM NO. 32	3 26 82
6	ADDENDUM NO 36	4 16 82
7	ADDENDUM NO 37 — 1/2 OF 2d FLOOR PERMIT	4-30-82
8	ADDENDUM NO 48	6 21-82
9	ADDENDUM NO 60	7-23 82
10	ADDENDUM NO. 67	8 6 82
11	ADDENDUM NO 73	9 15 82
12	ADDENDUM NO. 86	10-20 82
13	ADDENDUM NO. 88	10-28-82
14	ADDENDUM NO 97	1 13 83
15	ADDENDUM NO 109	3-23 83

APPROVED AS NOTED MAR 25 1983 BSD CONSTRUCTION

KEY PLAN

N

TRUCK DOCK SERVICE ENTRY

SCALE: 1/8" = 1'-0"

A 218

Norwalk
Building 43
Norwalk, California

Skidmore, Owings & Merrill
Architects/Engineers
One Maritime Plaza
San Francisco, California

Jaros, Baum & Bolles
Consulting Engineers
345 Park Avenue
New York, New York

Approved for the Owner by
Approved C 1846

Drawn by A. JOHANSEN
Job Number 10243 200
Checked by R. GRAZIANO
Date 10-28-81