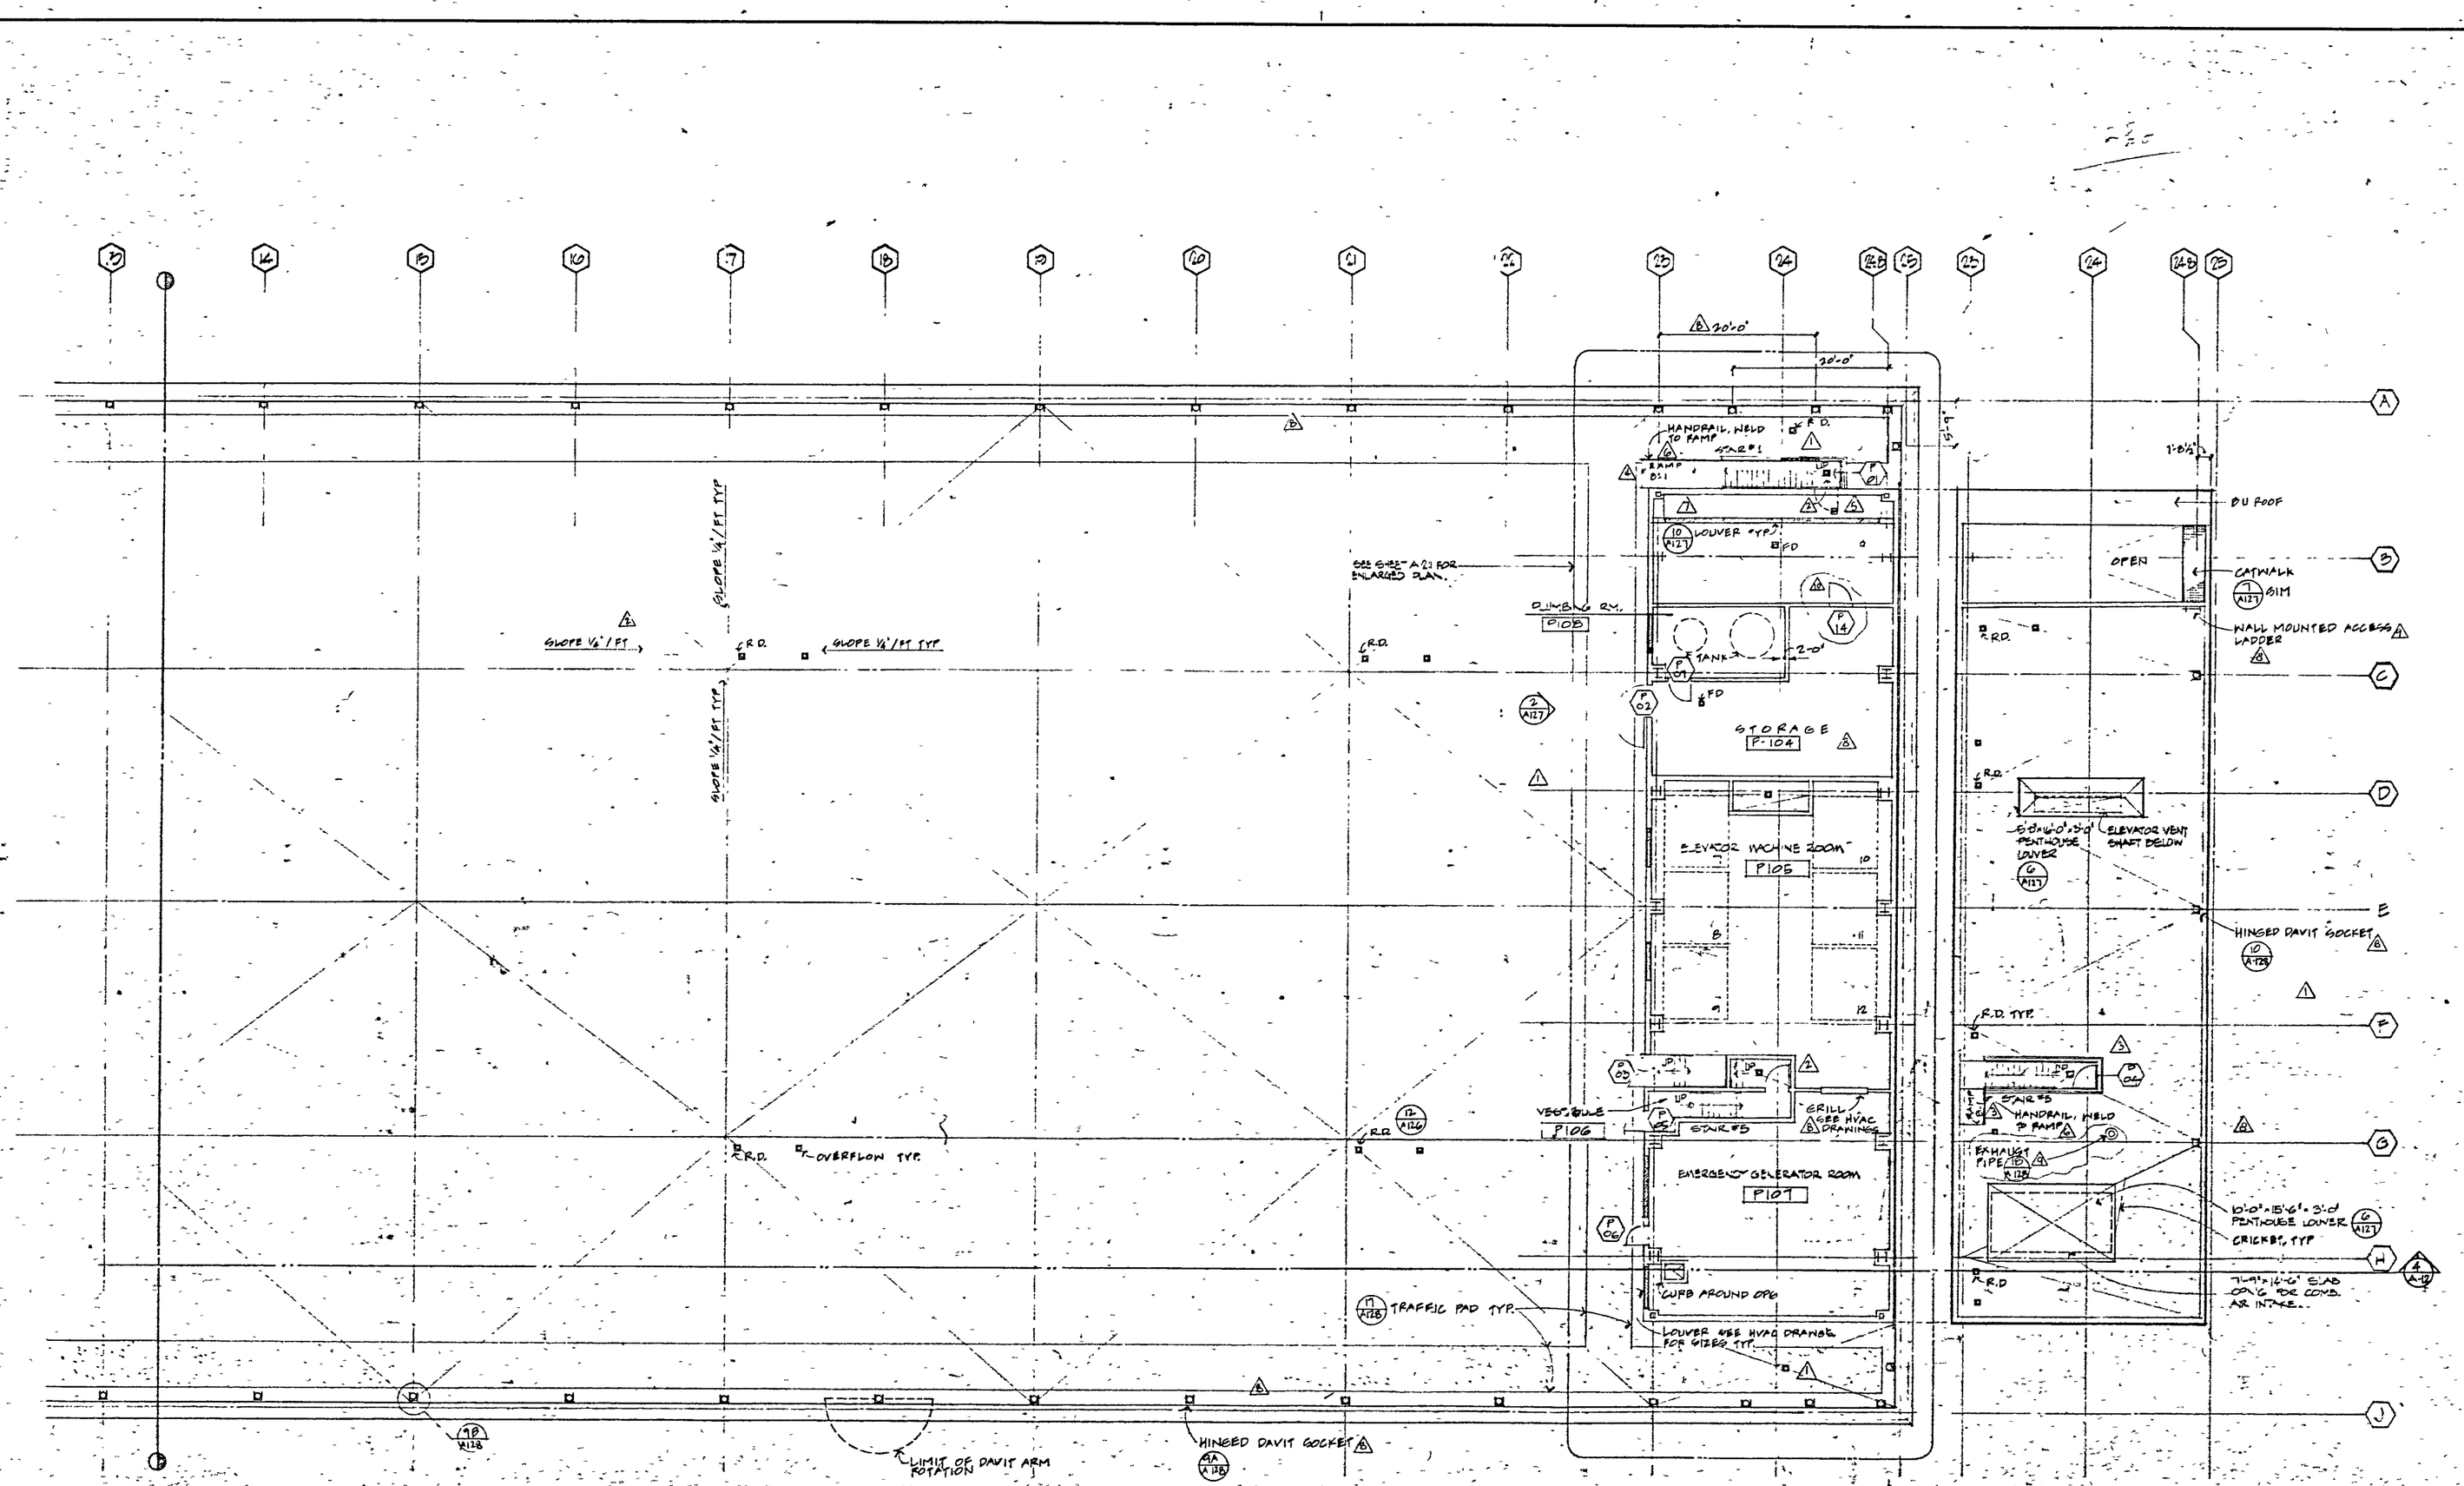

ROOM NO	TITLE	FLOOR MAT'L	BASE MAT'L	WALLS MAT'L	WALLS FIN	CEILING MAT'L	CEILING FIN	CEILING HT	REMARKS
P 104	STORAGE	SC	EC	STUCCO	LAT	EXP	—	—	
P 105	ELEV. MACH ROOM	CONC.	RB	GB	ECOSE	EXP	—	—	
P 106	VESTIBULE	CONC.	RB	GB	ECOSE	EXP	—	—	
P 107	EMERG GEN ROOM	EC.	EC.	GB	ECOSE	EXP	—	—	
P DB	D. WTR ELV ROOM	EC.	EC ⚠	GB	AT.	EXP	—	—	
	STAIR #1	CONC. ⚠	RB ⚠	STUCCO	LAT. ⚠	EXP	—	—	⚠ SEE NOTES 1,2
	STAIR #5	CONC. ⚠	RB ⚠	STUCCO	LAT. ⚠	EXP	—	—	⚠ SEE NOTES 1,2

PENTHOUSE / ROOF PLAN EAST

GENERAL NOTES:

1. STUCCO & EXT. STAIRWELLS TO RECEIVE LATEX FIN. (TYP.)
2. CONC. @ EXT. STAIRS TO RECEIVE ELASTOMERIC COATING.

Norwalk
Building 43
Norwalk, California

Skidmore, Owings & Merrill
Architects/Engineers
One Maritime Plaza
San Francisco, California

Jaros, Baum & Bolles
Consulting Engineers
345 Park Avenue
New York, New York

Approved for the Owner by

Approved by the Architect by — C-1846

Drawn by	Job Number
R.G. CHAPMAN	100203-200
Checked by: R.J. GRAZIANO	Date

Revisions

No.	Revisions indicated thus △	Date
	ISSUED FOR PRESENT BID	10.19.81
	ISSUED FOR ELEVATOR & DUMBWAITER BID	10.30.81
	ISSUED FOR METAL DECK BID	11/3/81
	ISSUED FOR CONCRETE BID ISSUED FOR FOUNDATION & P.E. PERMIT	12.8.81
	ISSUED FOR PLAN CHECK	1.21.82
	ISSUED FOR FINISH HARDWARE BID.	5.1.82
	ISSUED FOR HOLLOW METAL DOORS & FRAME BID.	3.1.82
	ISSUED FOR GYPSUM DRYWALL BID	3.1.82
	ISSUED FOR METAL LOUVER BID	3.12.82
1	ADDENDUM NO. 39	3.15.82
2	ADDENDUM NO. 37 ISSUED FOR BUILDING PERMIT	4.20.82
3	ADDENDUM NO. 45	6.21.82
4	ADDENDUM NO. 60	7.23.82
5	ADDENDUM NO. 73	9.15.82
6	ADDENDUM NO. 86	10.27.82
7	ADDENDUM NO. 88	11.28.82
8	ADDENDUM NO. 94	12.17.82
9	ADDENDUM NO. 102	2.3.83
10	ADDENDUM NO. 106	3.2.83

KEY PLAN

N

ROOF PLAN EAST

SCALE: 1/8" = 1'-0"

A-9