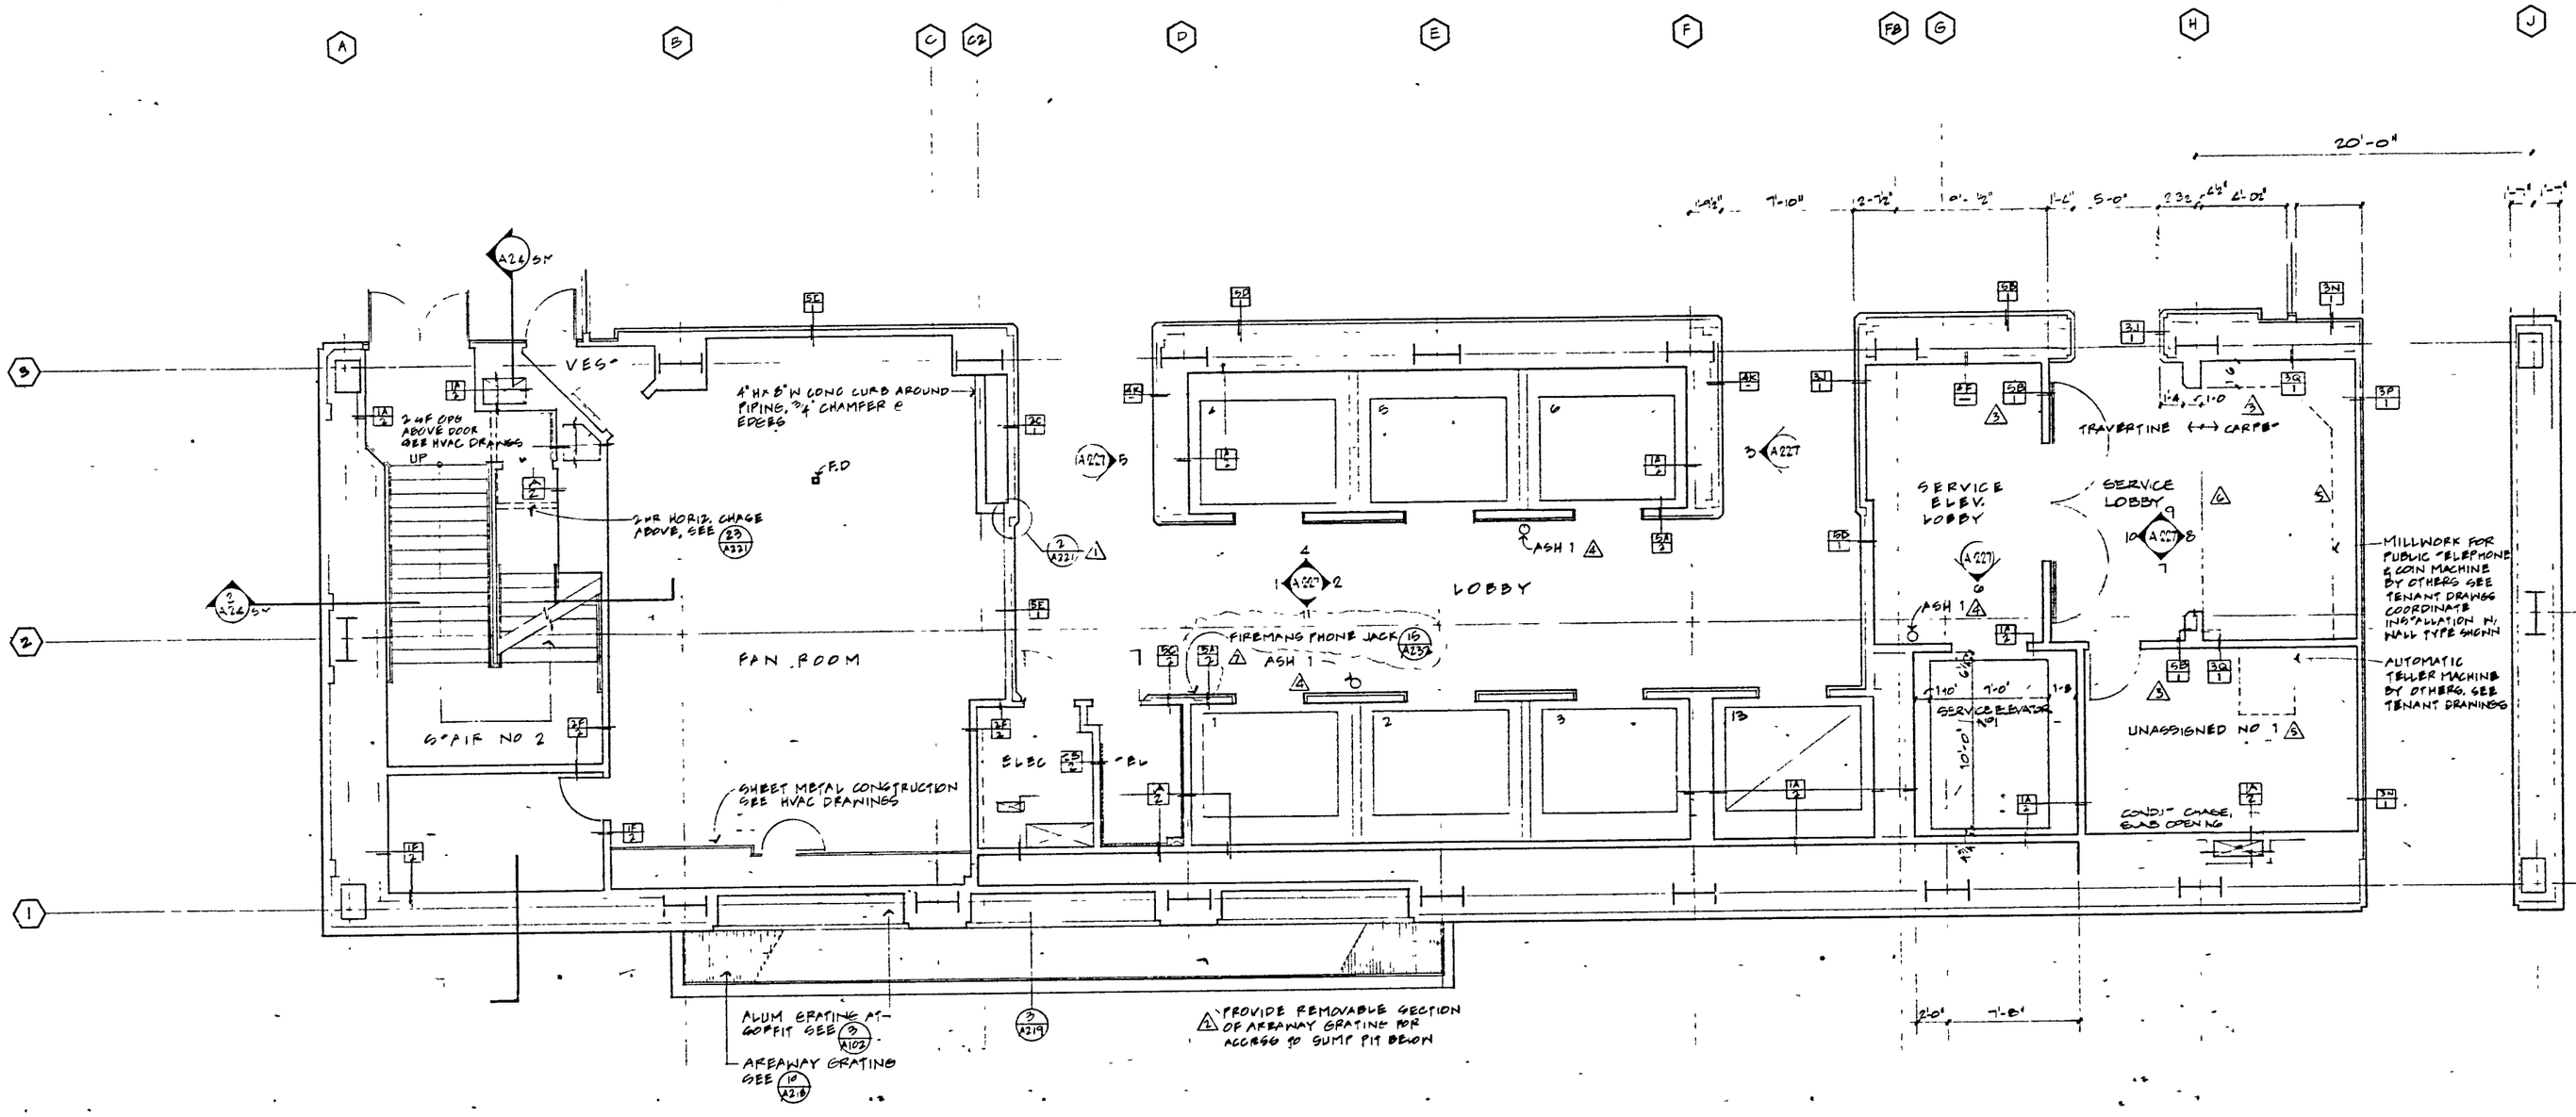

Norwalk
Building 43
Norwalk, California

Skidmore, Owings & Merrill
Architects/Engineers
One Maritime Plaza
San Francisco, California

Jaros, Baum & Bolles
Consulting Engineers
345 Park Avenue
New York, New York

Approved for the Owner by

Approved for the Architect by C-1846

Drawn by E. DAVID | Job Number 10293-200

Checked by R.V. GRAZIANO | Date

Revisions

No.	Revisions indicated thus △	Date
1	SOLICITED FOR ELEVATOR & DUMBWAITER BID	10-30-81
2	SOLICITED FOR METAL DECK BID	11-30-81
3	SOLICITED FOR STEEL STAIR BID	12-7-81
4	ISSUED FOR WINDOW BID	1-25-82
5	ISSUED FOR PLAN CHECK	1-29-82
6	ISSUED FOR STONE & PAVING BID	2-24-82
7	ISSUED FOR GYPSUM DRYWALL BID	3-4-82
△1	ADDENDUM NO. 91	3-24-82
△2	ADDENDUM NO. 96	4-16-82
△3	ADDENDUM NO. 97 ISSUED FOR BUILDING PERMIT	4-26-82
△4	ADDENDUM NO 52 ISSUED FOR HANDICAPPED HARDWARE	7-1-82
△5	ADDENDUM NO. 88	12-28-82
△6	ADDENDUM NO 97	1-13-83
△7	ADDENDUM NO. 116	4-26-83

RECEIVED
APR 27 1983
B.S.A. CONSTRUCTION

KEY PLAN

N

CORE PLAN, LEVEL 2 - GROUND FLOOR WEST

SCALE: 1/4" = 1'-0"

A-205