

Norwalk
Building 43

Norwalk, California

Skidmore, Owings & Merrill
Architects/Engineers
One Maritime Plaza
San Francisco, California

Jaros, Baum & Bolles
Consulting Engineers
345 Park Avenue
New York, New York

Approved for the Owner by

Approved for the Architect by


Drawn by
D. FALTA
Job Number
10202-200
Checked by
Date
9-9-81

Revisions

No.	Revisions Indicated Thus Δ	Date
1	ISSUE FOR STRUCTURAL STEEL SCOPE BID.	9-9-81
2	ISSUE FOR STRUCTURAL STEEL MILL ORDER	9-23-81
3	ADDENDUM NO. 1	
4	ADDENDUM NO. 2	10-7-81
5	ISSUE FOR STRUCTURAL STEEL DETAILS	10-28-81
6	ADDENDUM NO. 4	
7	ISSUED FOR METAL DECK BID.	11-3-81
8	ADDENDUM NO. 8	11-18-81
9	ADDENDUM NO. 11	12-7-81
10	ISSUED FOR CONCRETE BID	12-8-81
11	ISSUED FOR FOUNDATION & PILE PERMIT	
12	ADDENDUM NO. 15	1-15-82
13	ISSUED FOR PLAN CHECK	1-29-82
14	ADDENDUM NO. 26	1-24-82
15	ADDENDUM NO. 32	3-26-82
16	ADDENDUM NO. 37	4-30-82
17	ISSUED FOR BUILDING PERMIT	
18	ADDENDUM NO. 41	5-17-82

SHO B. TAYLOR SE1117


KEY PLAN

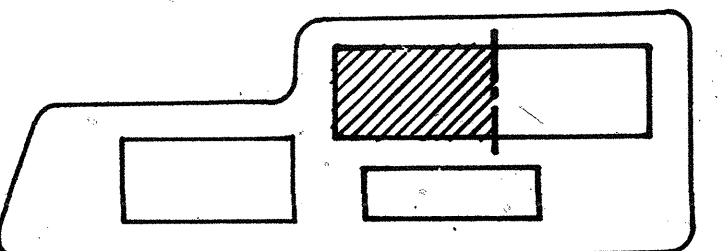

Level 3 -
Framing Plan /
West

Scale : 1/8" = 1' - 0"

S 8

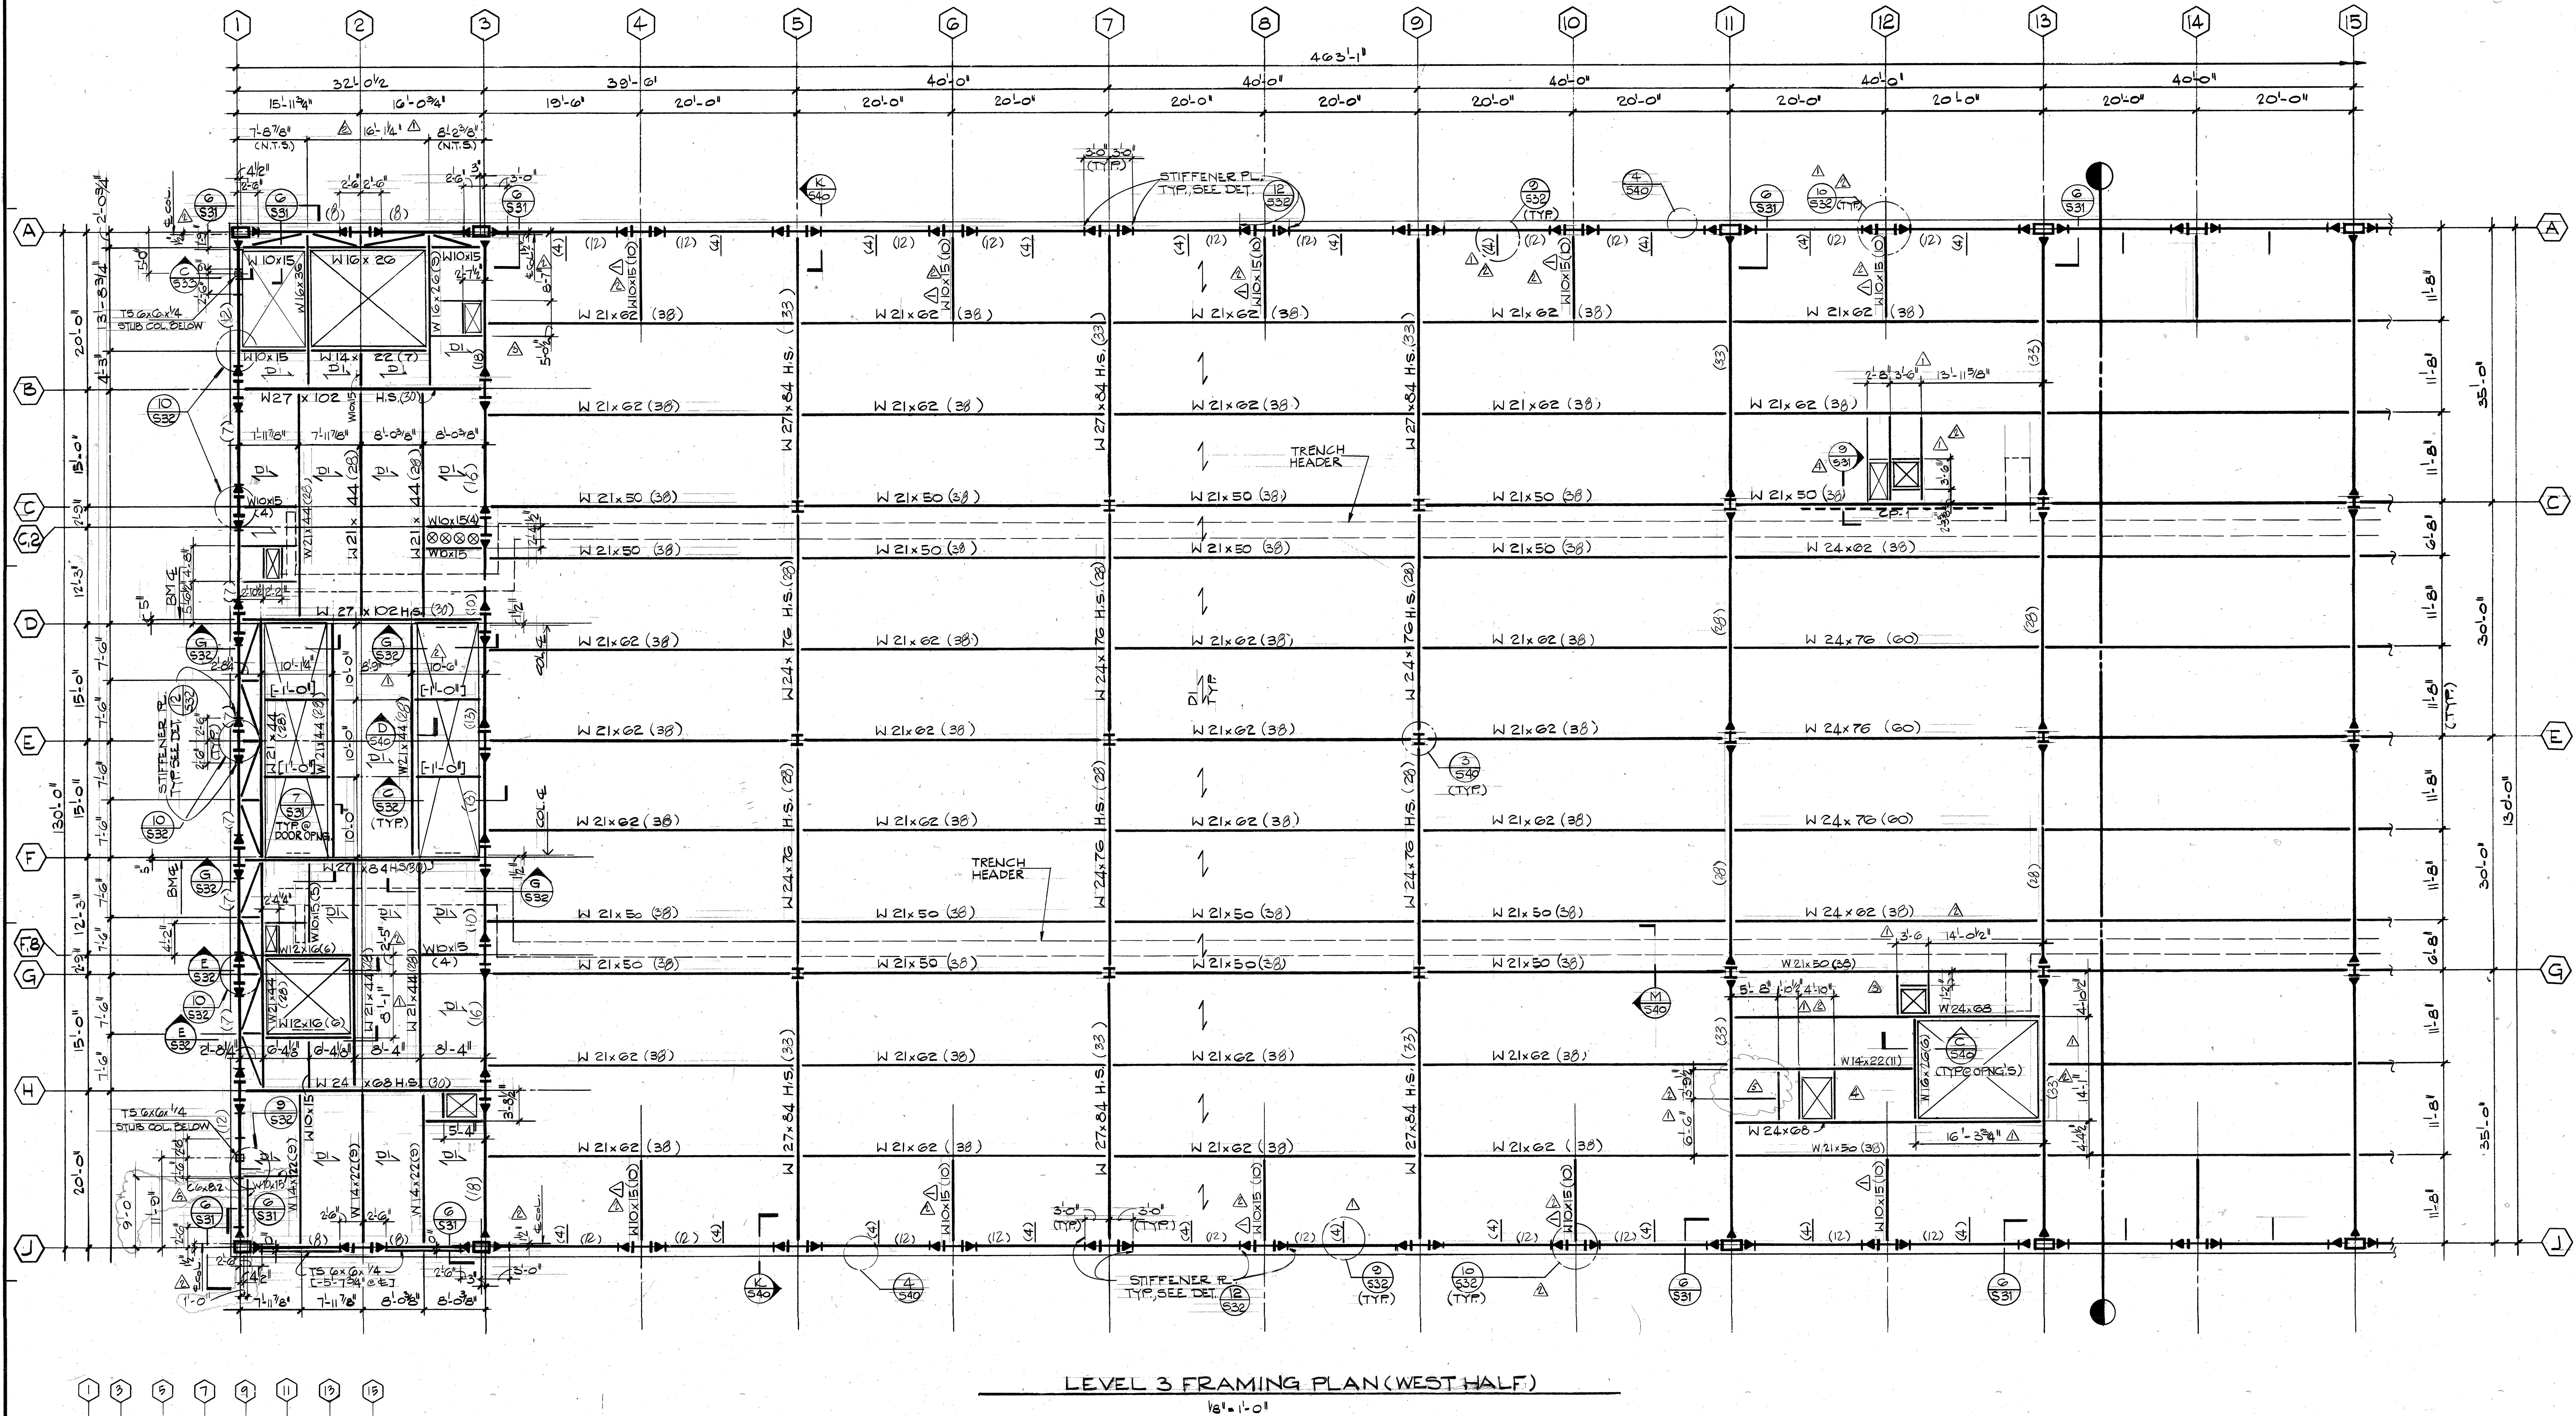

LEVEL 3 FRAMING PLAN (WEST HALF)

1/8" = 1' - 0"

AREA A. TYPICAL	PSF	AREA B. LIGHT STORE	PSF	AREA C. FAN ROOM	PSF
2 1/2" N.W. CONC. FILL ON 3" METAL DECK PARTITIONS CEILING FIREPROOF & MISC.	53	2 1/2" N.W. CONC. FILL ON 3" METAL DECK PARTITIONS CEILING FIREPROOF & MISC.	53	2 1/2" N.W. CONC. FILL ON 3" METAL DECK 4" FLOATING FLOOR (1) 6" HOUSEKEEPING PAD(1) CEILING FIREPROOF & MISC.	100
DEAD LOAD	83	DEAD LOAD	83	DEAD LOAD	188
LIVE LOAD (1)	80	LIVE LOAD (2)	125	LIVE LOAD (1)	75

(1) REDUCED LOAD CAPACITY FOR DESIGN ONLY
(2) NOT REDUCED NOT FOR CONSTRUCTION

NOTES

- REFERENCE ELEVATION = 110'-0" TOP OF STEEL [O-5/21] WITH RESPECT TO REFERENCE ELEVATION UNLESS NOTED THUS [1'-11" O-5/21]
- FOR GENERAL NOTES SEE 600 SEE 630 SEE 640 FOR TYPICAL STEEL DETAILS SEE 630 SEE 640 FOR TYPICAL METAL DECK DETAILS SEE 630 SEE 640 FOR COLUMNS & FRAME GIRDERS SEE 630 SEE 640
- FOR MISCELLANEOUS FRAMING AROUND FLOOR OPENINGS SEE 630