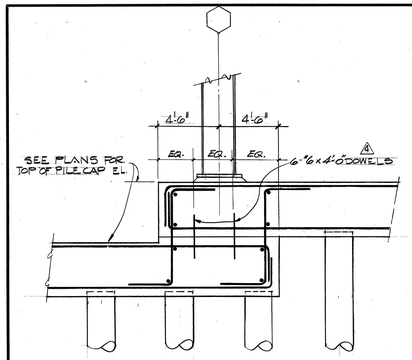

SECTION A
1/4"=1'-0"

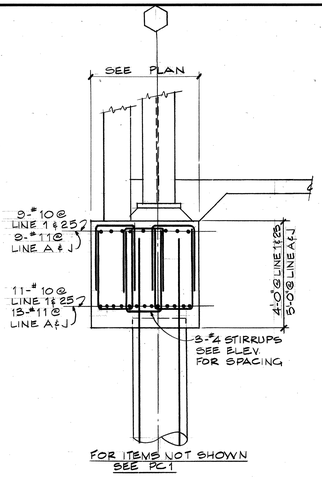

PC 3

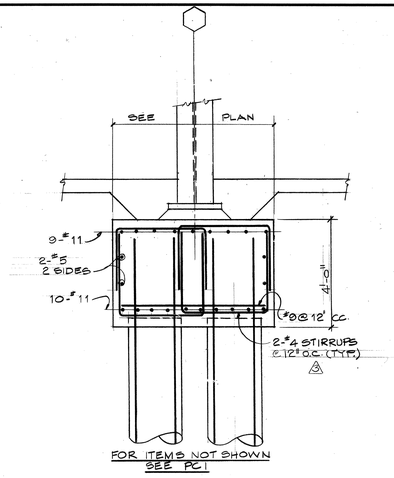

PC 2

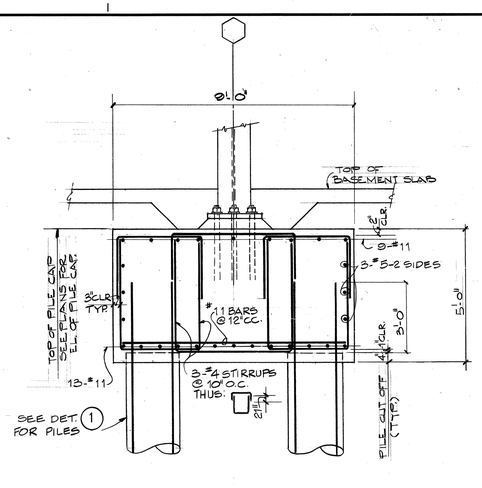

PC 1

TYPICAL PILE CAP DETAILS (2)
1/2"=1'-0"

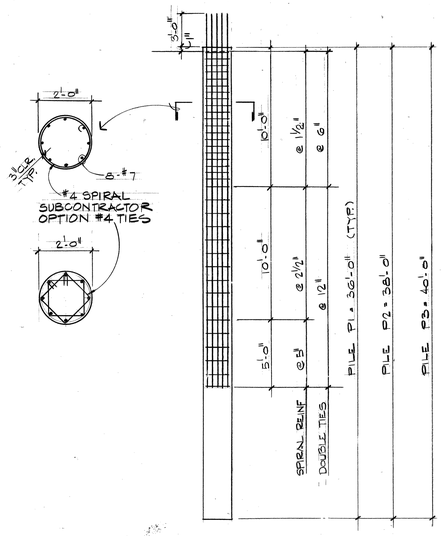

TYPICAL PILE DETAILS (1)
NO SCALE

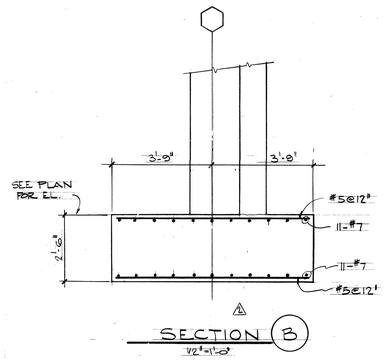

SECTION B
1/2"=1'-0"

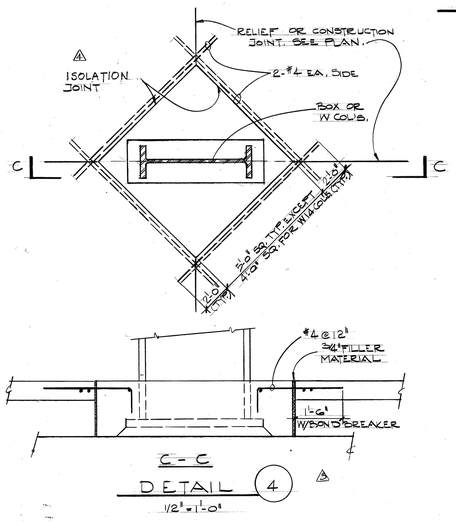

C – C
DETAIL (4)
1/2"=1'-0"

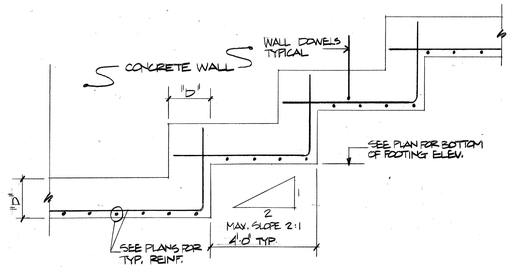

TYPICAL STEPPED FOOTING
NO SCALE

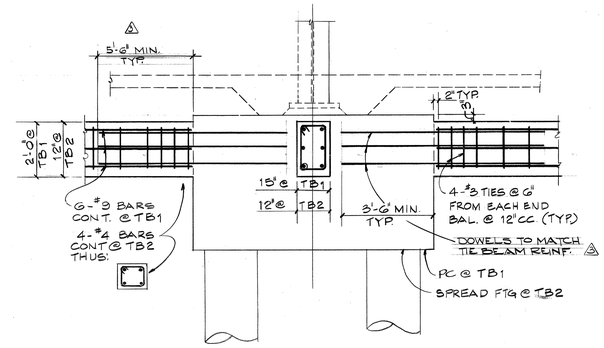

TYPICAL TIE BEAM DETAIL (3)

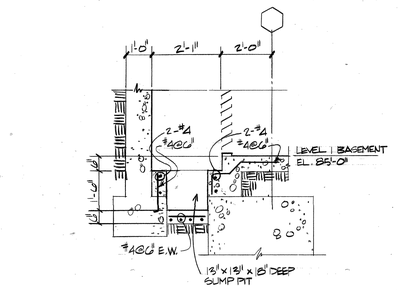

TYPICAL SUMP PIT (C)
1/2"=1'-0"

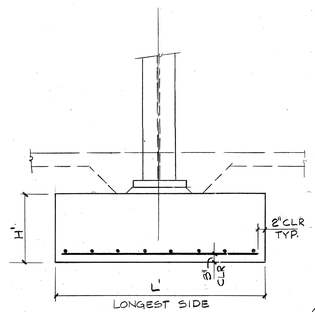

FOOTING SCHEDULE					
FOOTING MARKS	FTG. SIZE B' x L' x H'	LONG BARS TOP	LONG BARS BOTT.	SHORT BARS TOP	SHORT BARS BOTT.
CF1	7'-6"x7'-6"x1'-6"	—	9-#5	—	9-#5
CF2	9'-6"x9'-6"x1'-6"	—	10-#5	—	10-#5
CF3	10'-0"x10'-0"x1'-6"	—	10-#5	—	10-#5
CF4	10'-9"x10'-9"x2'-0"		11-#7		11-#7
F1	2'-6"x2'-6"x1'-6"		6-#6		6-#6
TF1	13'-6"x13'-6"x2'-6"		13-#7		13-#7
TF2	13'-6"x19'-9"x2'-6"	13-#7	13-#7	13-#7	22-#7
TF3	11'-3"x11'-3"x2'-0"		11-#7		11-#7
TF4	13'-0"x13'-9"x2'-0"		14-#7		10-#7
TF5	9'-0"x11'-9"x2'-0"		8-#7		10-#7
TF6	8'-9"x8'-9"x2'-0"		9-#6		9-#6

NOT USED

Norwalk
Building 43

Norwalk, California

Skidmore, Owings & Merrill
Architects/Engineers
One Maritime Plaza
San Francisco, California

Jaros, Baum & Bolles
Consulting Engineers
345 Park Avenue
New York, New York

Approved for the Owner by

Approved for the Architect by

Drawn by	Job Number
D. FALOTAS	10295-200
Checked by	Date

Revisions

No.	Revisions Indicated thus △:	Date
	ISSUED FOR PILE BID,	11-23-81
	ISSUED FOR CONCRETE BID ISSUED FOR FOUNDATION AND PILE PERMIT	12-8-81
1	ADDENDUM NO. 12	12-8-81
2	ADDENDUM NO. 13	12-29-81
	ISSUED FOR PLAN CHECK	1-29-82
3	ADDENDUM NO. 26	2-24-82
4	ADDENDUM NO. 32	3-26-82
5	ADDENDUM NO. 36	4-16-82
	ADDENDUM NO. 37 ISSUED FOR BUILDING PERMIT	4-30-82
6	ADDENDUM No 47	6-11-82

Erle B. Tryde SE 1117

KEY PLAN

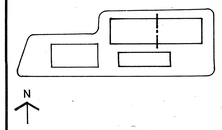

Pile and Footing Details

Scale as noted

S 51