

Norwalk  
Building 43

Norwalk, California

Skidmore, Owings & Merrill  
Architects/Engineers  
One Maritime Plaza  
San Francisco, California

Jaros, Baum & Bolles  
Consulting Engineers  
345 Park Avenue  
New York, New York

Approved for the Owner by

Approved for the Architect by

Drawn by


Checked by

Revisions

No.	Revisions Indicated thus Δ:	Date
1	ISSUE FOR STRUCTURAL STEEL SCOPE BID.	9-9-81
2	ISSUE FOR STRUCTURAL STEEL MILL ORDER ADDENDUM NO. 1	9-23-81
3	ADDENDUM NO. 2	10-7-81
4	ISSUE FOR STRUCTURAL STEEL DETAILING ADDENDUM NO. 4	10-28-81
5	ISSUED FOR METAL DECK BID	11-3-81
6	ADDENDUM NO. 8	11-8-81
7	ADDENDUM NO. 9	11-23-81
8	ADDENDUM NO. 11	12-7-81
9	ISSUED FOR CONCRETE BID	12-8-81
10	ISSUED FOR FOUNDATION & PILE PERMIT	1-13-82
11	ADDENDUM NO. 15	1-13-82
12	ISSUED FOR PLAN CHECK	1-29-82
13	ADDENDUM NO. 26	2-24-82
14	ADDENDUM NO. 37	4-30-82
15	ISSUED FOR BUILDING PERMIT	5-17-82
16	ADDENDUM NO. 41	5-17-82
17	ADDENDUM NO. 43	5-21-82
18	ADDENDUM NO. 86	10-20-82
19	ADDENDUM NO. 88	10-28-82
20	ADDENDUM NO. 94	12-17-82
21	ADDENDUM NO. 101	1-21-83
22	ADDENDUM NO. 119	5-6-83

8/10 B. Truitt SE 1117


KEY PLAN

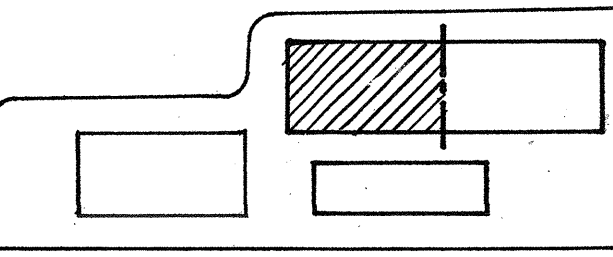

Roof Framing Plan /  
West

Scale: 1/8" = 1' - 0"

S 12

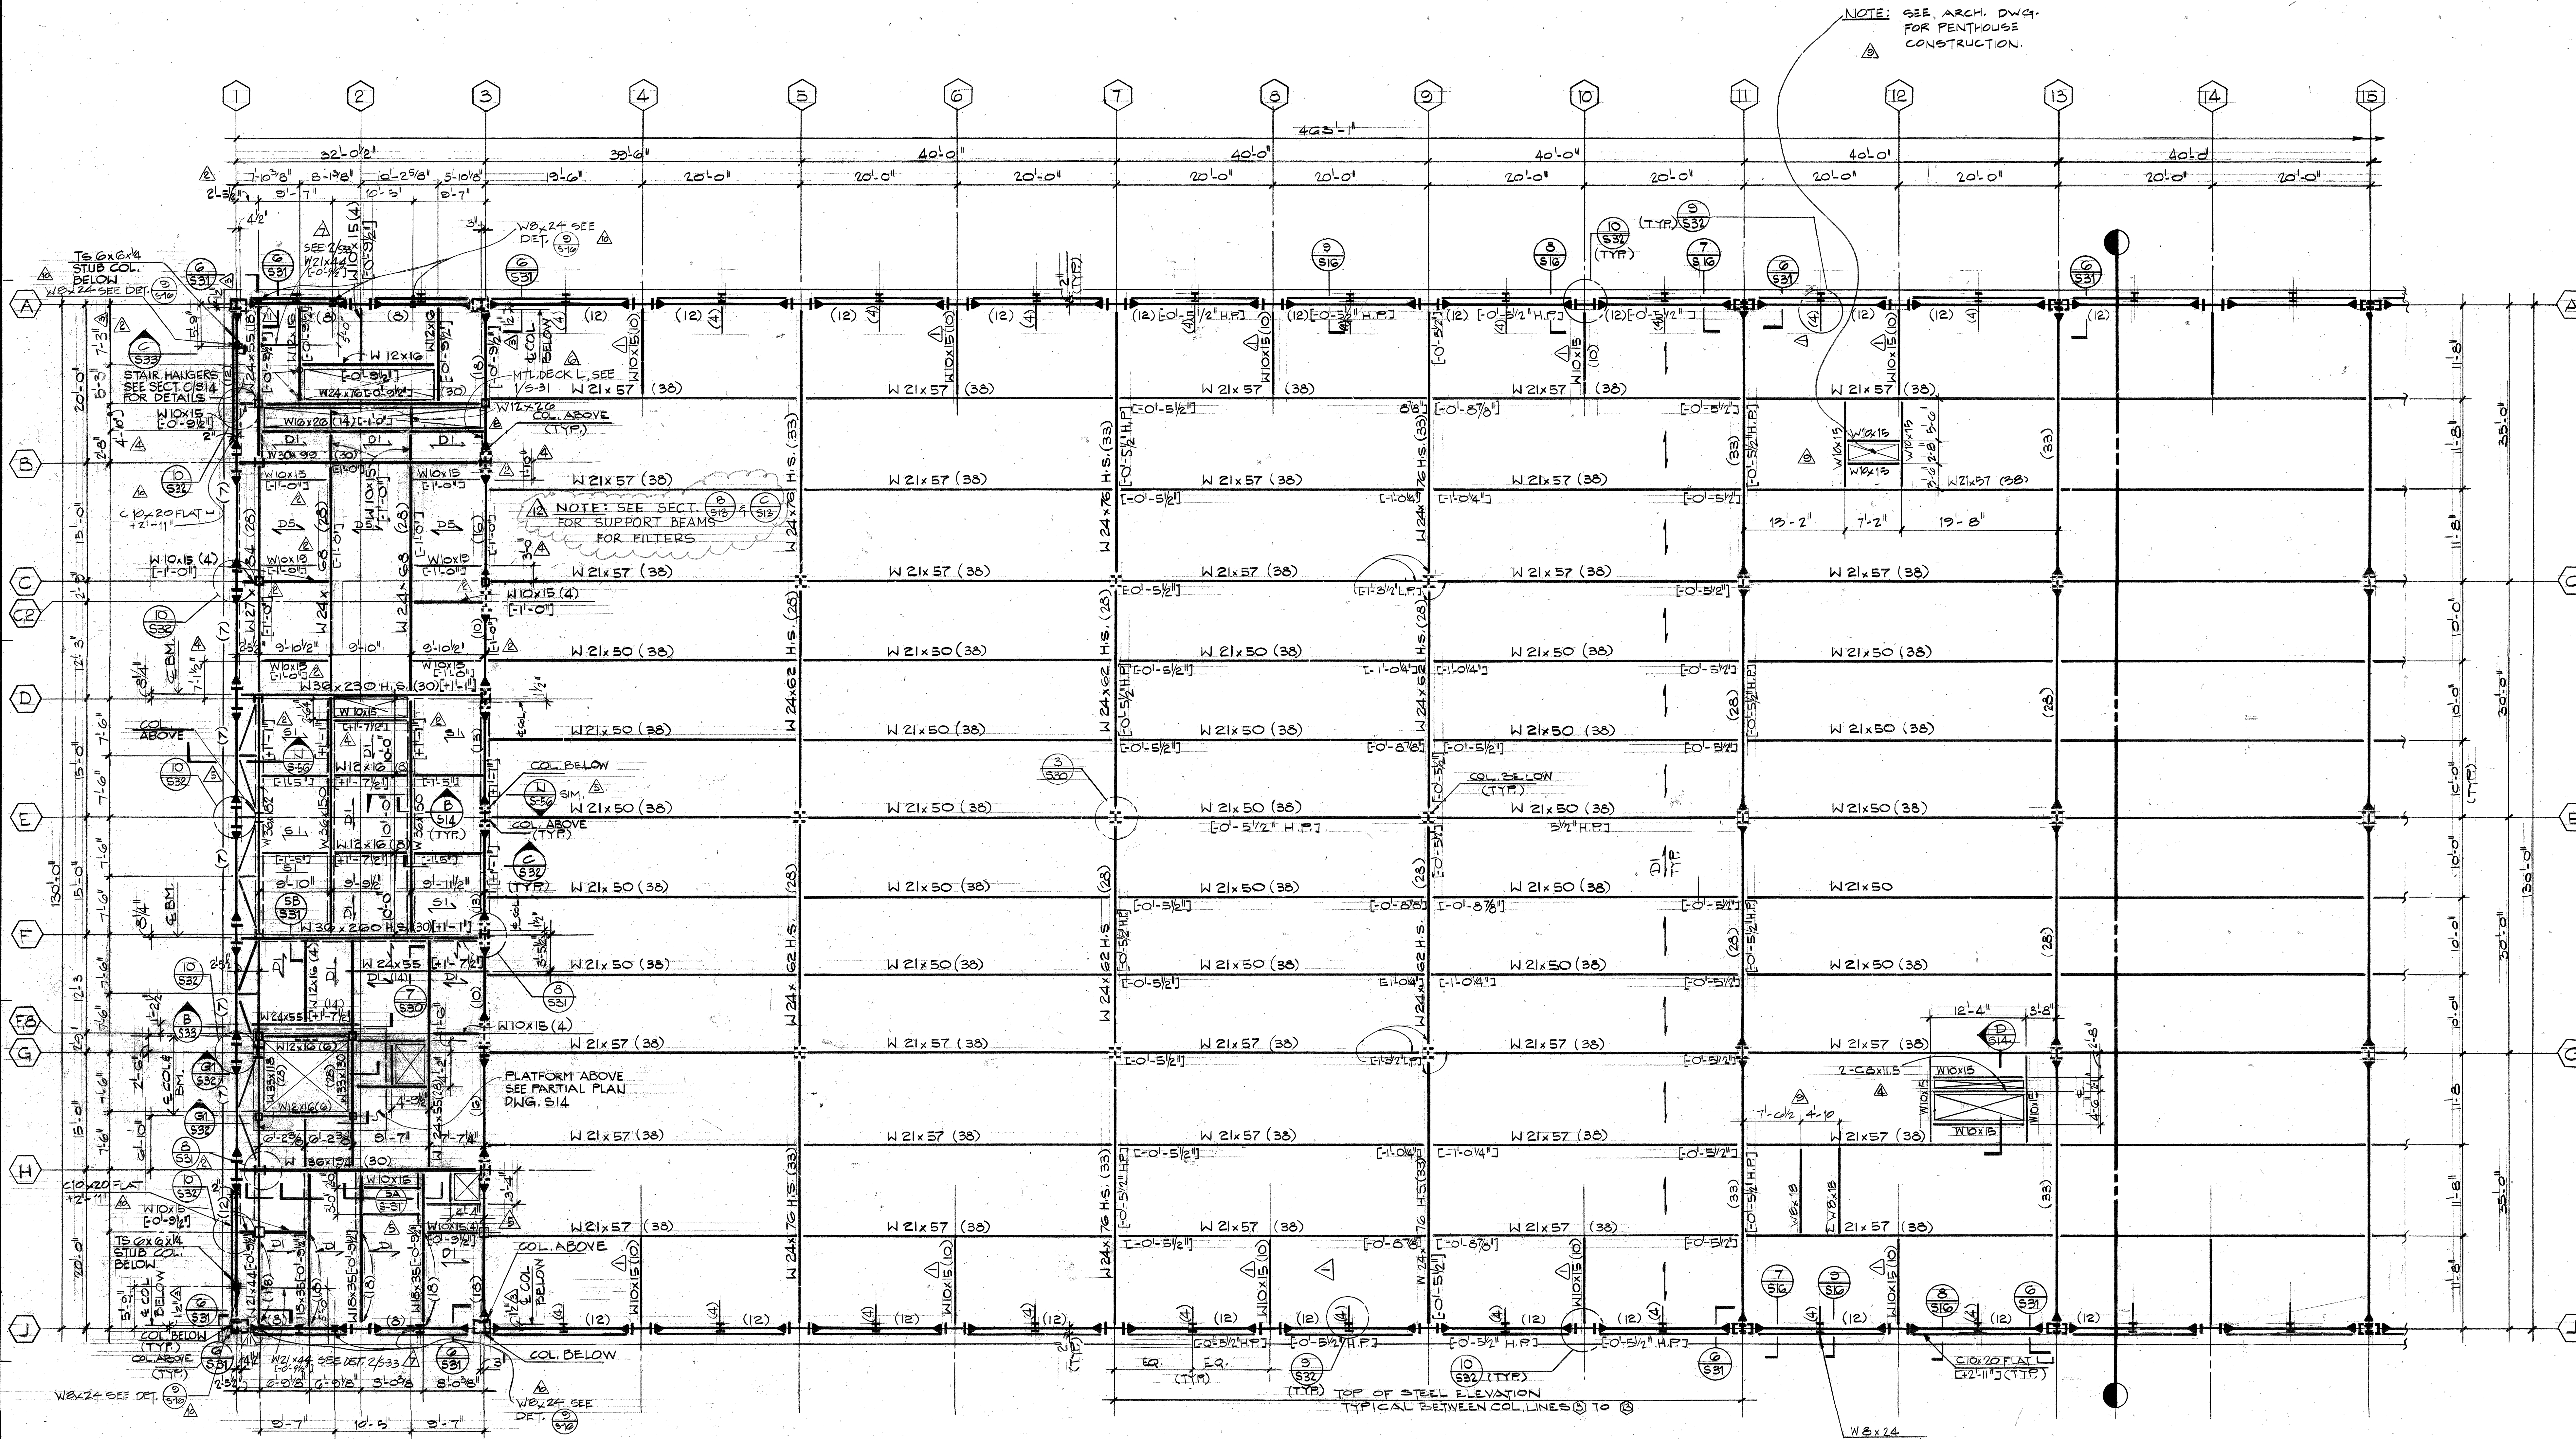

ROOF PLAN (WEST HALF)

1/8" = 1'-0"

AREA A, TYPICAL	PSF	AREA B, EQUIP.	PSF	AREA C, ELEV.	PSF
2 1/2" N.W. CONC. FILL ON 3" METAL DECK	53	2 1/2" N.W. CONC. FILL ON 3" METAL DECK	53	6" N.W. CONC. FILL ON 3" HOUSEKEEPING PAD	75
CEILING	10	6" HOUSEKEEPING PAD	75	MISC.	5
ROOFING & INSULATION	5	CEILING	5		
FIREPROOF & MISC.	5	FIREPROOF & MISC.	5		
DEAD LOAD	73	DEAD LOAD	133	DEAD LOAD	155
LIVE LOAD (2)	20	LIVE LOAD (1) (3)	75	LIVE LOAD (1) (3)	75
(1) REDUCED					
(2) NOT REDUCED					
(3) MAJOR EQUIP. LOADS APPLIES AS OCCURS					

LOAD CAPACITIES FOR DESIGN ONLY  
NOT FOR CONSTRUCTION

NOTES

1. REFERENCE ELEVATION = 198'-11" TOP OF STEEL [C-15/21] WITH RESPECT TO REFERENCE ELEVATION UNLESS NOTED THUS: [C-15/21].
2. FOR GENERAL NOTES SEE 500. FOR TYPICAL STEEL DETAILS SEE 530. FOR TYPICAL METAL DECK DETAILS FOR COLUMNS & FRAME GIRDERS SEE 530.
3. FOR MISCELLANEOUS FRAMING AROUND FLOOR OPENINGS SEE 537.