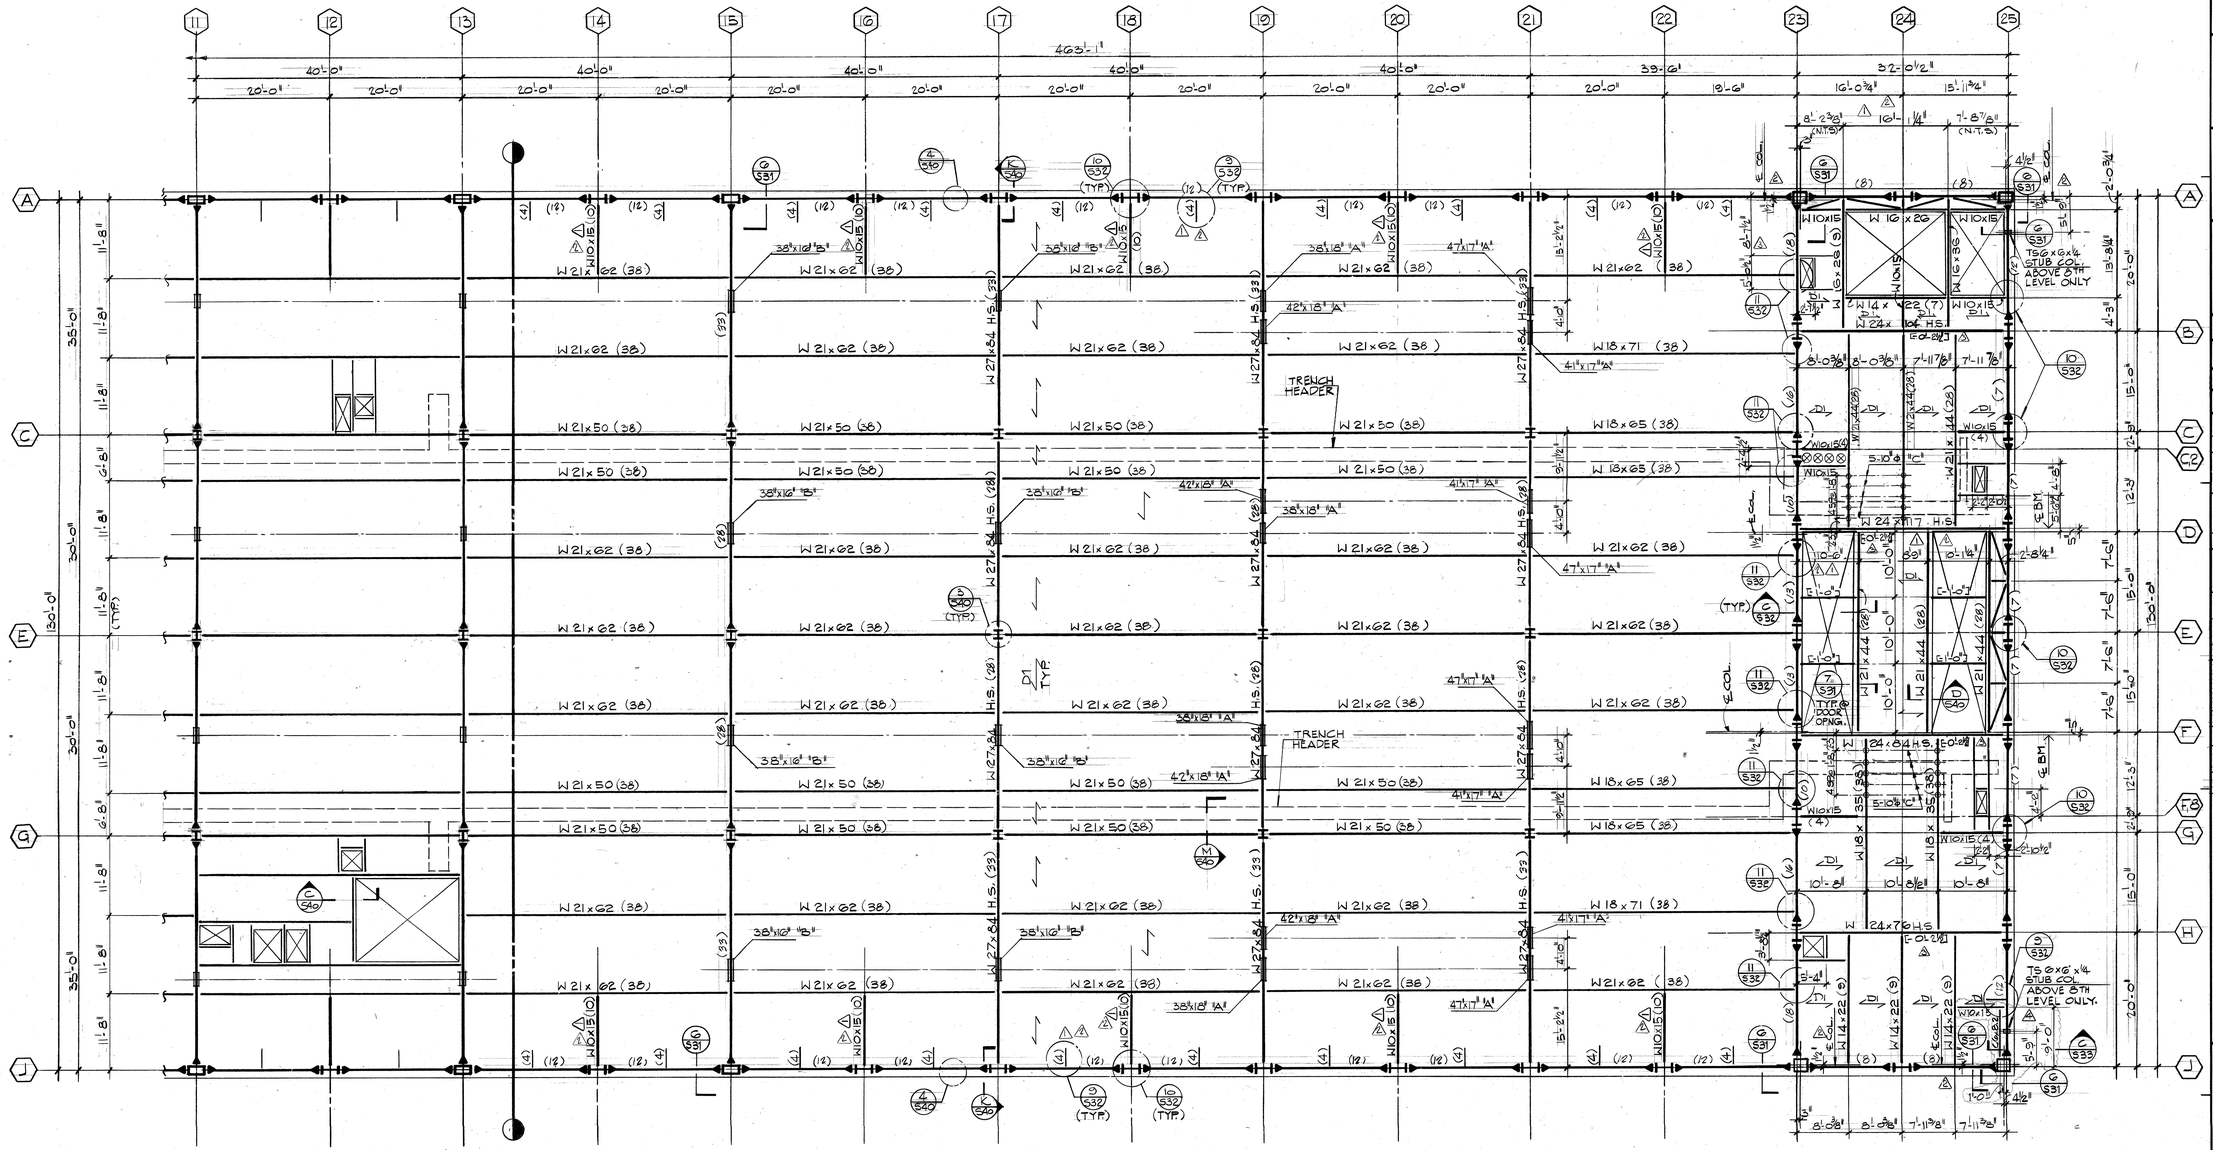

TYPICAL FLOOR PLAN - (LEVELS 4-8, EAST HALF)

1/8"=1'-0"

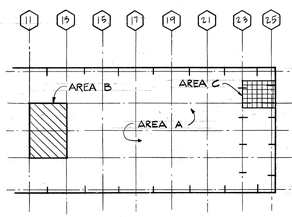

AREA A. TYPICAL	PSF.	AREA B. LIGHT STORE	PSF.	AREA C. FAN ROOM	PSF.
2½" N.W. CONC. FILL ON 3" METAL DECK	53	2½" N.W. CONC. FILL ON 3" METAL DECK	53	2½" N. W. CONC. FILL ON 3" METAL DECK	53
PARTITIONS	20	PARTITIONS	20	4" FLOATING FLOOR (1)	50
CEILING	5	CEILING	5	6" HOUSKEEPING PAD(1)	75
FIREPROOF & MISC.	5	FIREPROOF & MISC.	5	CEILING	5
				FIREPROOF & MISC.	5
DEAD LOAD	83	DEAD LOAD	83	DEAD LOAD	188
LIVE LOAD (1)	80	LIVE LOAD (2)	125	LIVE LOAD (1)	75
(1) REDUCED (2) NOT REDUCED					


NOTES

1. REFERENCE ELEVATION = TOP OF STEEL [0'-0 1/2"] WITH RESPECT TO REFERENCE ELEVATION UNLESS NOTED THUS: [-1'-0 1/2"]
2. FOR GENERAL NOTES SEE 80; FOR TYPICAL STEEL DETAILS SEE 530; FOR TYPICAL METAL DECK DETAILS SEE 540; FOR COLUMNS & FRAME GIRDERS SEE 615 510
3. FOR MISCELLANEOUS FRAMING AROUND FLOOR OPENINGS SEE 532

4	129'-4"
5	142'-8"
6	156'-0"
7	169'-4"
8	182'-8"

Norwalk
Building 43

Norwalk, California

Skidmore, Owings & Merrill
Architects/Engineers
One Maritime Plaza
San Francisco, California

Jaros, Baum & Bolles
Consulting Engineers
345 Park Avenue
New York, New York

Approved for the Owner by

Approved for the Architect by

Drawn by	Job Number
D.PALGTA.S	10235-200
Checked by	Date
	3-5-81

Revisions

No.	Revisions indicated thus △:	Date
	ISSUE FOR STRUCTURAL STEEL SCOPE BID.	9-9-81
	ISSUE FOR STRUCTURAL STEEL MILL ORDER ADDENDUM NO 1	9-23-81
	ADDENDUM NO. 2	07-81
	ISSUE FOR STRUCTURAL STEEL DETAILING ADDENDUM NO.4	10.28.81
	ISSUED FOR METAL DECK BID.	11-3-81
1	ADDENDUM NO. 8	11-18-81
2	ADDENDUM NO. 11	12-7-81
	ISSUED FOR CONCRETE BID ISSUED FOR FOUNDATION & PILE PERMIT	12.8.81
3	ADDENDUM NO. 15	1-15-82
	ISSUED FOR PLAN CHECK	1-29-82
	ADDENDUM NO. 37 ISSUED FOR BUILDING PERMIT	4-30-82
4	ADDENDUM NO. 41	5-17-82

Edward B. Taylor SE1117

KEY PLAN

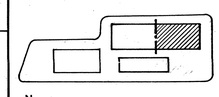

Levels 4, 5, 6, 7, 8
Typical Floor
Framing Plans / East

Scale: 1/8" = 1' - 0"

S 9